


T.40S. R.19E. W.M.

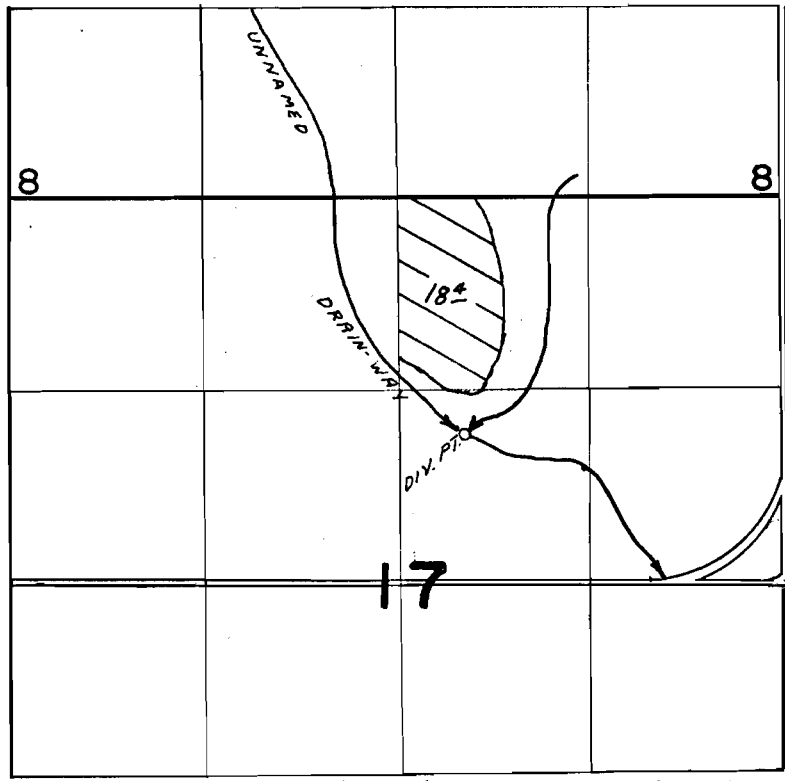

DIV. PT. LOC. 1020' N & 450' E FROM CENTER SEC. 17

FINAL PROOF SURVEY UNDER

Application No. 48325 Permit No. 36288
IN NAME OF

LEROY M. STEWART

Surveyed JUL 11 1975, by L.H. NUNN