


36709
94743

T.39S.,R.19E.,W.M.

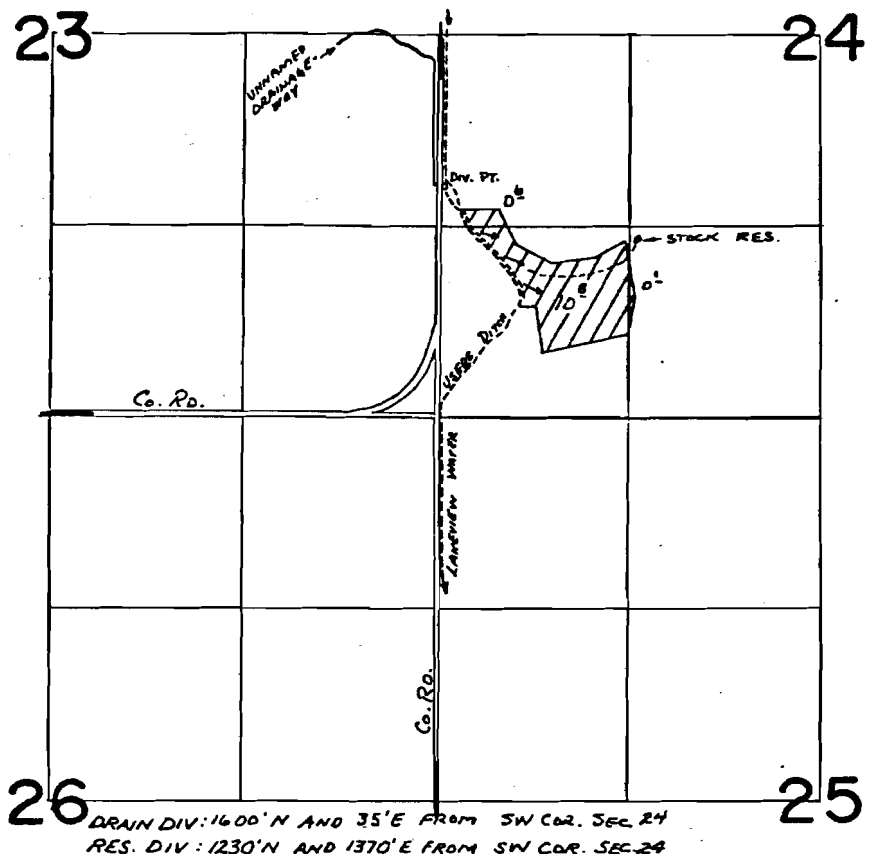

FINAL PROOF SURVEY UNDER

R-52814 R-6366
 52784 39614
 Application No. 49900 Permit No. 36709
 IN NAME OF

ALBERT ROGERS

Surveyed Oct. 13, 1975, by L. T. H.
 OCT. 21 1976 R. MUCKEN