


38861

44744

T. 40 S. R. 19 E. W. M.

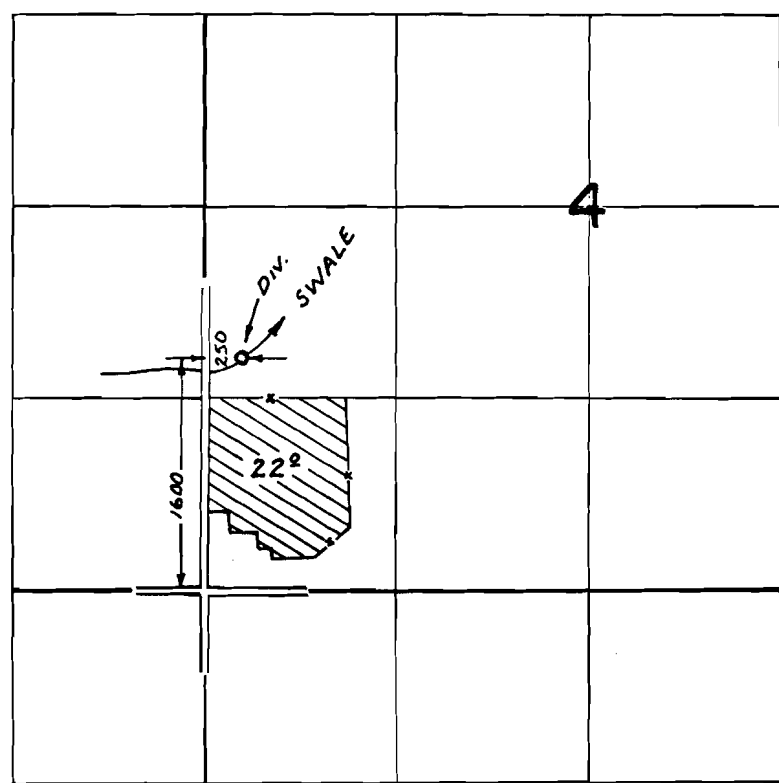

FINAL PROOF SURVEY UNDER

Application No. 51487 Permit No. 38861
IN NAME OF

JESS ROBERTS

Surveyed OCT. 21, 1976, by R. MUGKEN