


T.39S.,R.19E.,W.M.

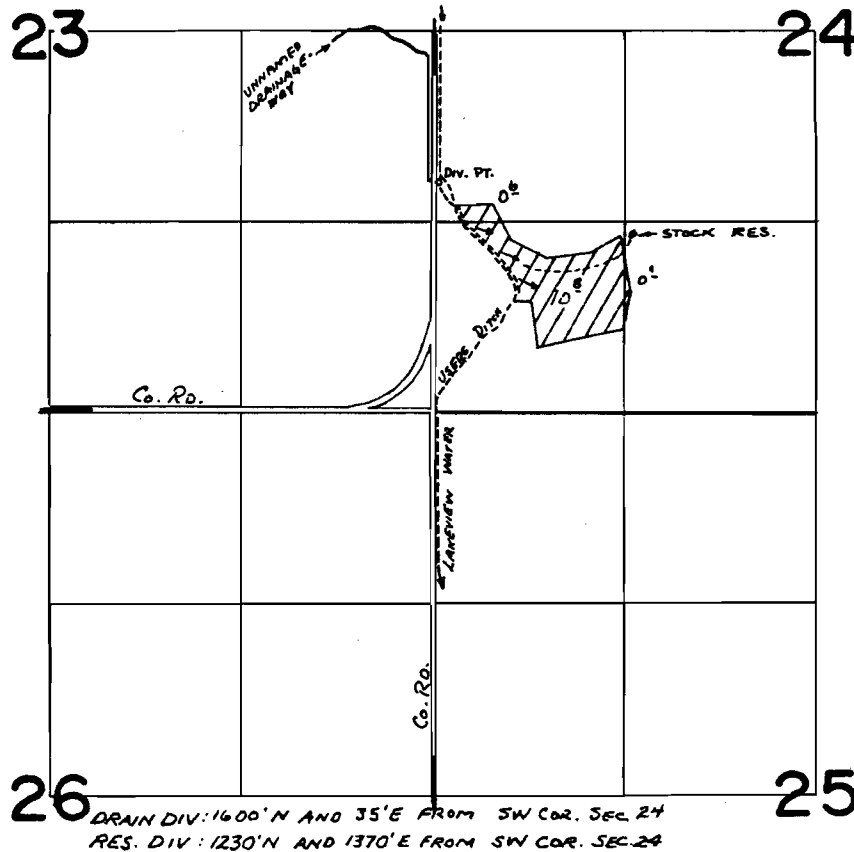

FINAL PROOF SURVEY UNDER

R-52814 R-6366
 52784 39614
 Application No. 49900. Permit No. 36709.
 IN NAME OF

ALBERT ROGERS

Surveyed Oct. 13, 1975, by J. Toll
 OCT. 21 1976 R. MUCKEN