


T.16S. R.3W. W.M.

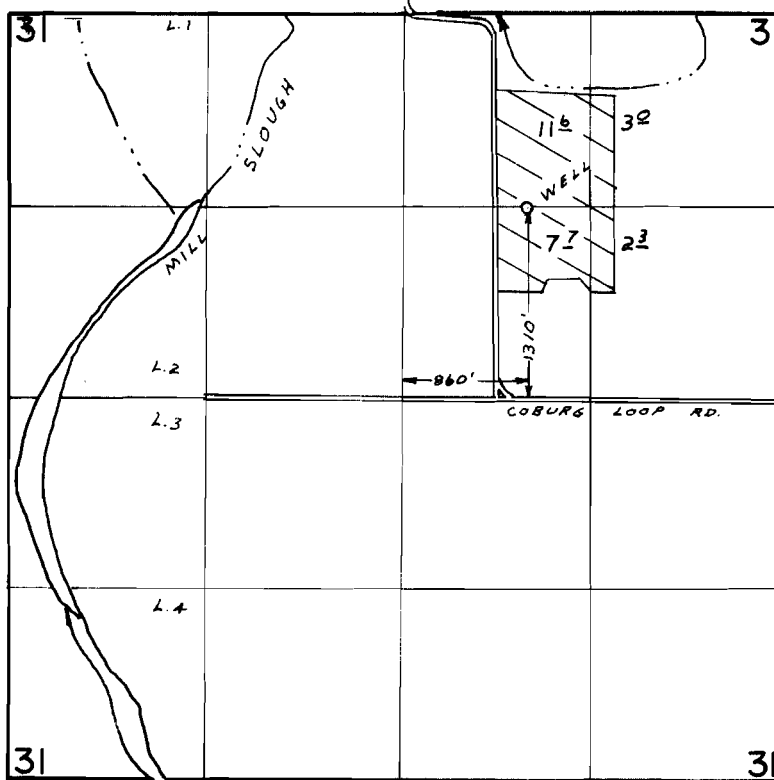

FINAL PROOF SURVEY
UNDER

Application No. G-5411 Permit No. G-5344
IN NAME OF

HARRY HARBERT

Surveyed SEP. 24, 1975, by L.H. NUNN