


T.17S.,R.8W.,W.M.

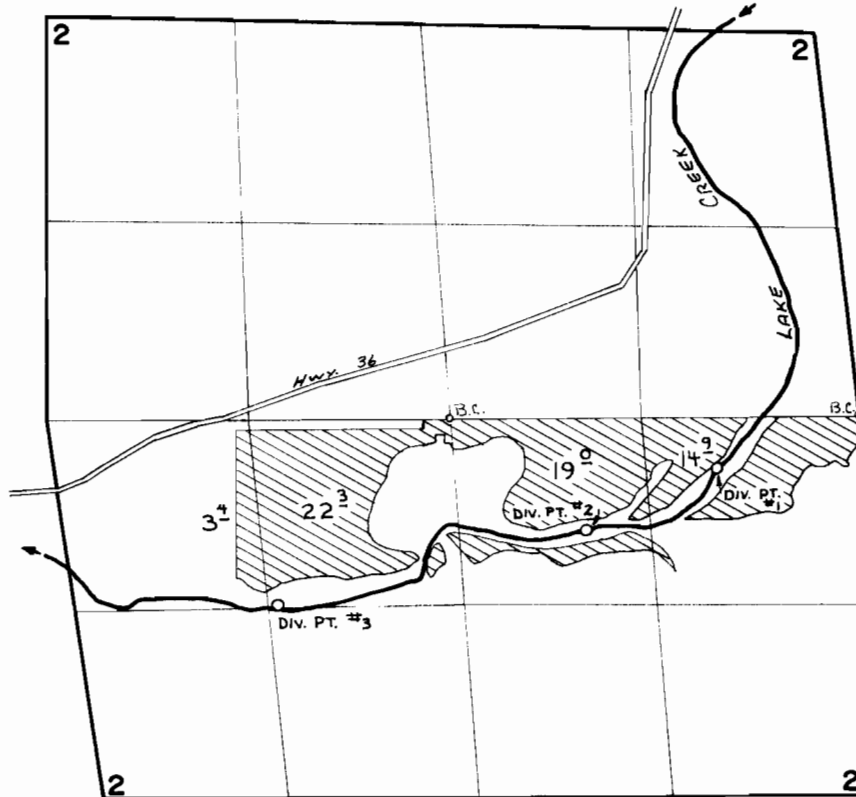

DIV. PT. #1- 350'S AND 1820'E }  
DIV. PT. #2- 770'S AND 920'E } ALL FROM C<sup>1</sup>/<sub>4</sub> COR. SEC. 2  
DIV. PT. #3- 1280'S AND 1180'W }

**FINAL PROOF SURVEY**  
UNDER

Application No. **41129** Permit No. **30662**  
IN NAME OF

**J. W. SMITH**

Surveyed Oct. 31 1974, by **L. H. NUNN**