


T.17S. R.2W. W.M.

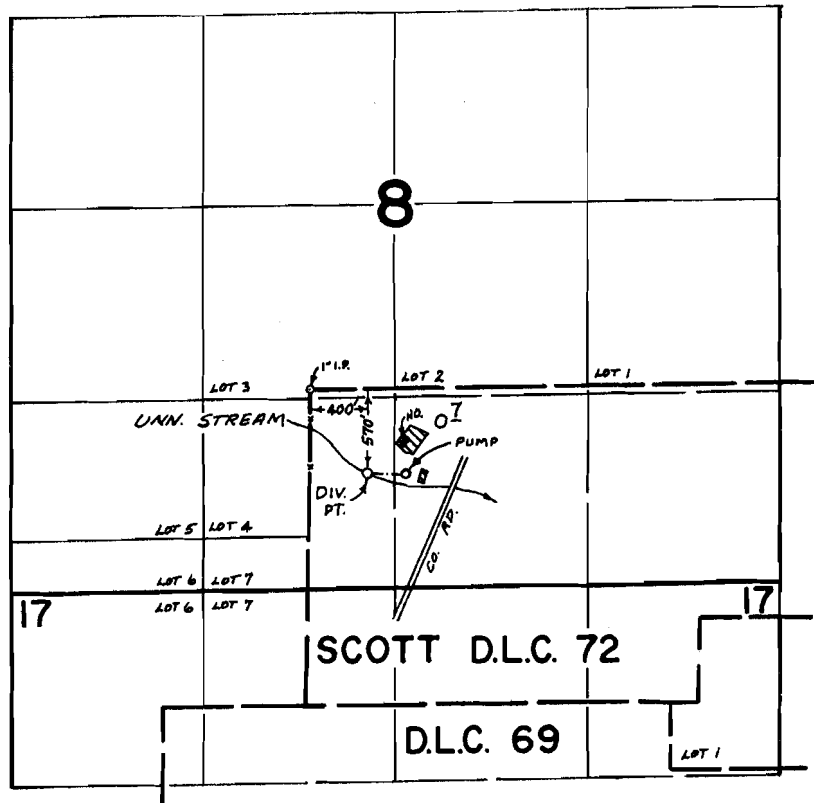

FINAL PROOF SURVEY

UNDER

Application No. 44430 Permit No. 33185

IN NAME OF

LARRY E. MULLARKEY

Surveyed JULY 7 1975, by L. TOLL