


27

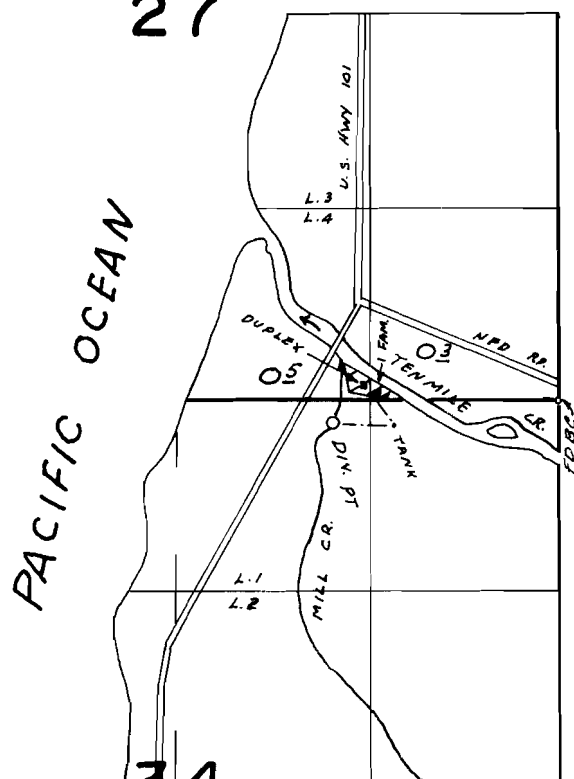

DIV. PT. LOC. 160' S & 1550' W FROM
NE COR. SEC. 34.

Application No. 45487 Permit No. 33943
IN NAME OF

BRUCE H. BAUER

Surveyed JUN 19 1975, by L.H. NUNN.....