


T.16 S. R.7 & 8 W. W.M.

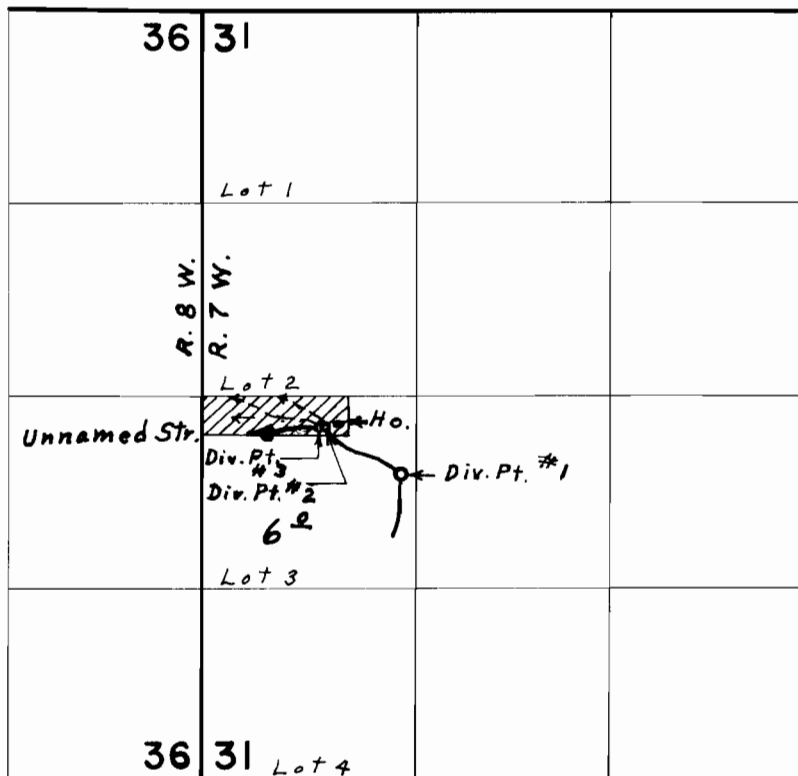

Div. Pts. loc.; #1, 540' S. & 1360' E., #2, 210' S. & 840' E., #3, 220' S. & 800' E., all from N.W. Cor. N.W. $\frac{1}{4}$ S.W. $\frac{1}{4}$ Sec. 31

FINAL PROOF SURVEY UNDER

Application No. 46526 Permit No. 34760
IN NAME OF
WILLIAM FEIGEL

Surveyed Nov. 6, 1975, by L. E. Gould