


T.19S. R.12W. W.M.

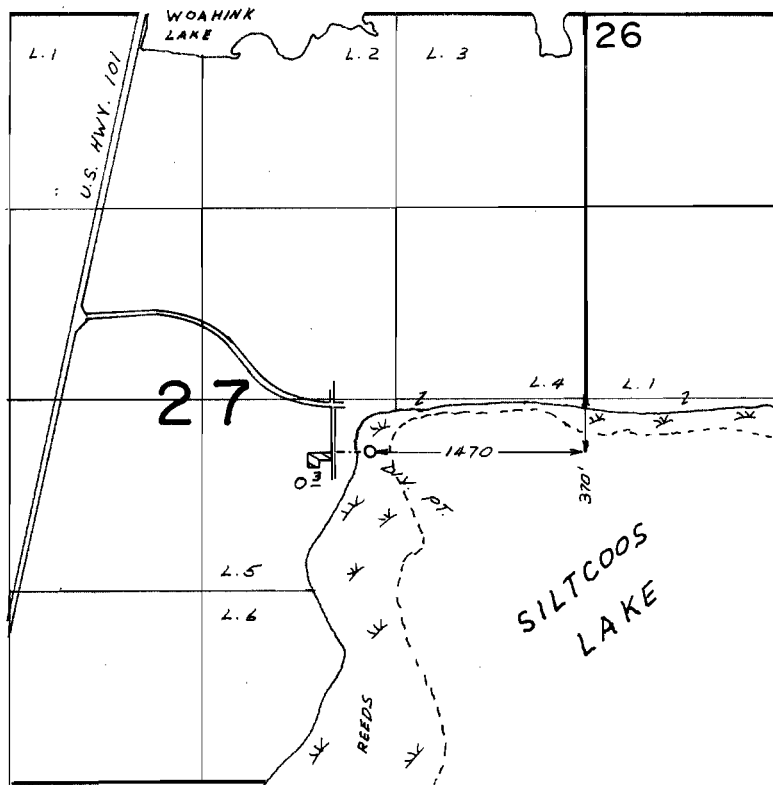

FINAL PROOF SURVEY UNDER

Application No. 47925 Permit No. 35901
IN NAME OF

ARCHIE VERMILYEA

Surveyed JUN. 24. 1975, by L.H. NUNN