

RECEIVED


OCT 7 1974  
STATE ENGINEER  
SALEM, OREGON

RECEIVED

MAY 28 1974  
STATE ENGINEER  
SALEM, OREGON

RECEIVED

MAR 12 1974  
STATE ENGINEER  
SALEM, OREGON

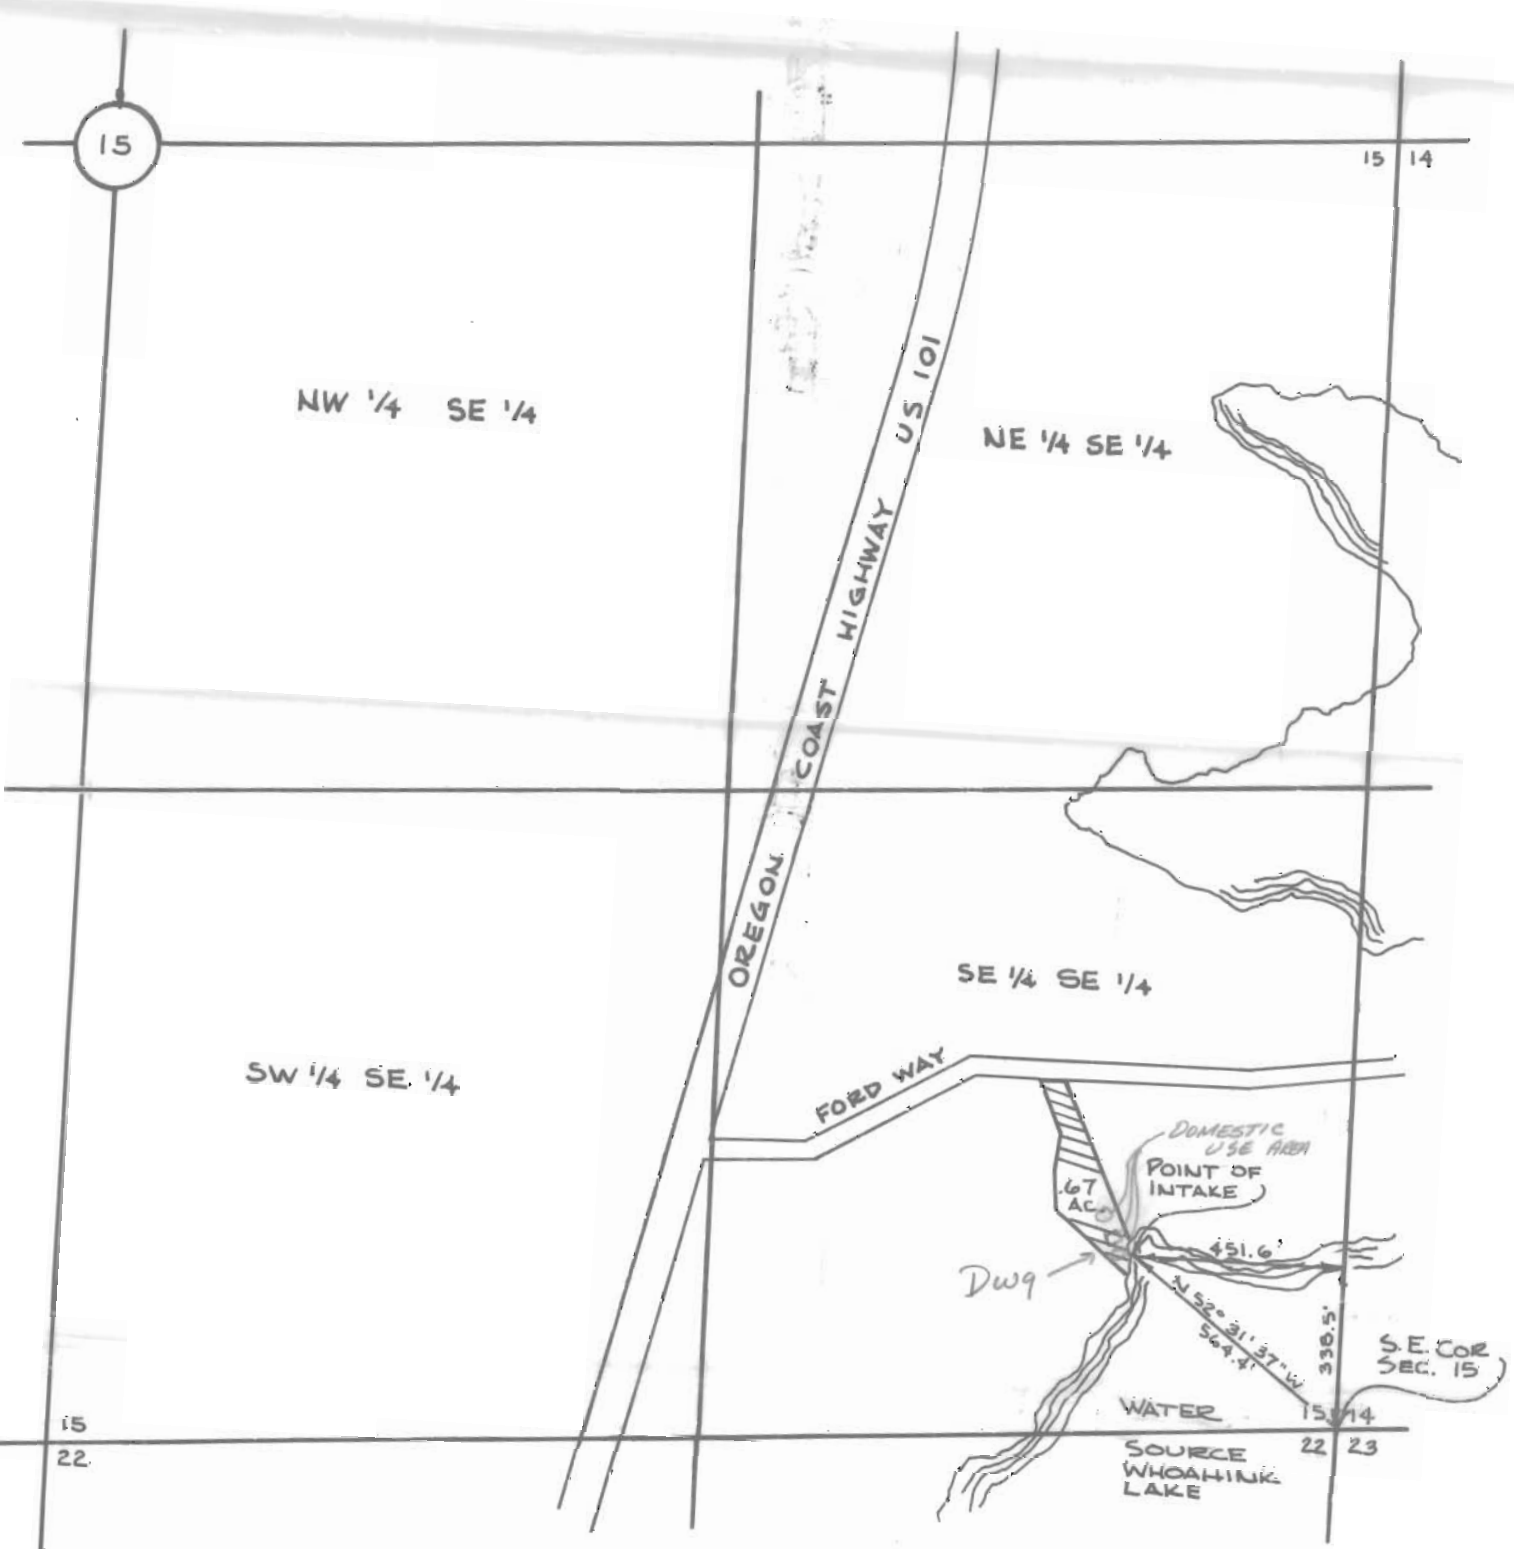

WATER RIGHT MAP  
ROBERT READ

REVISED 9-23-74  
SE 1/4, SEC. 15, T19S, R 12 W, WM  
LANE COUNTY, OREGON

PLANTS & FRITTON, Inc.  
54 CENTENNIAL LOOP  
EUGENE, OREGON 97401  
503/686-9211



Application No. 51741  
Permit No. 37544