


T.13 S., R.11-12 W., W.M.

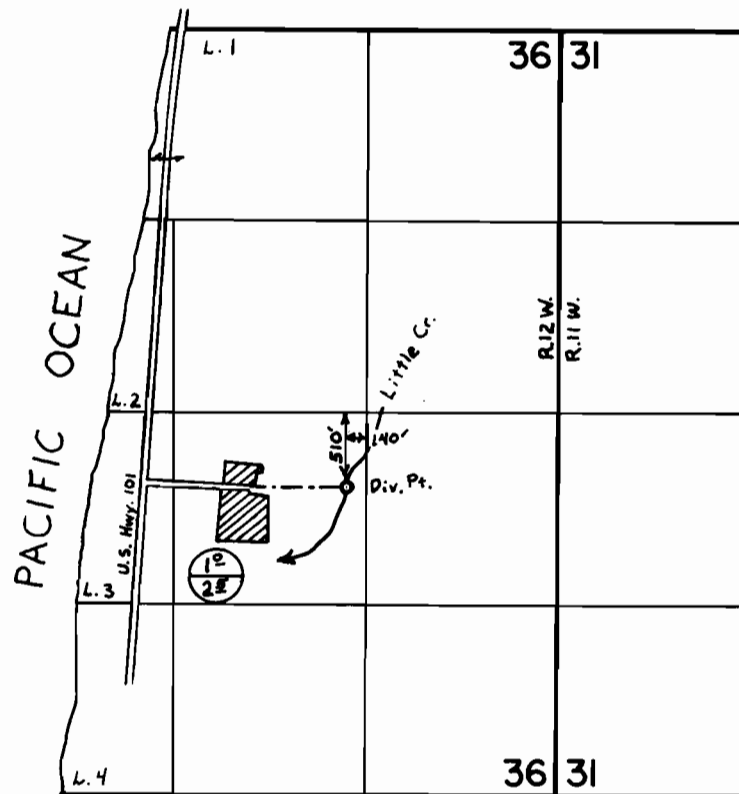

○ Permit \* 31908  
○ Permit \* 39096

**FINAL PROOF SURVEY**  
UNDER

52039 39096  
Application No. 42705 Permit No. 31908  
IN NAME OF

HARRY WALTER & DORIS M. ERIKSEN

Surveyed JUNE 7 1974, by L. NUNN  
AUG. 10 1976 D. NORBY