


T.13S., R.11-12W., W.M.

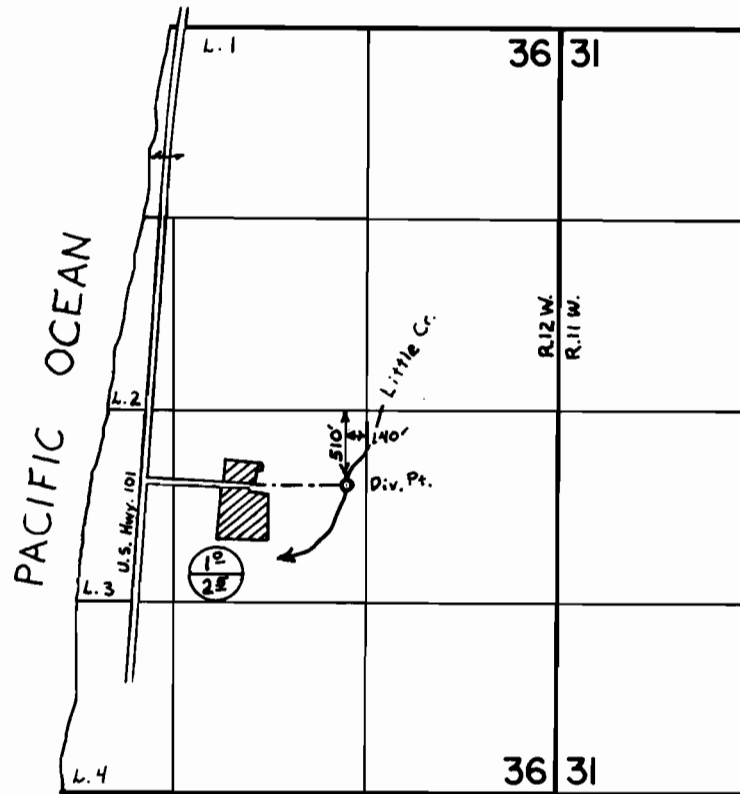

○ Permit * 31908
○ Permit * 39096

FINAL PROOF SURVEY UNDER

52039 39096
Application No. 42705 Permit No. 31908
IN NAME OF

HARRY WALTER & DORIS M. ERIKSEN

Surveyed JUNE 7 1974, by L. NUNN
AUG. 10 1976 D. NORBY