


T. 12S., R. 11W., W.M.

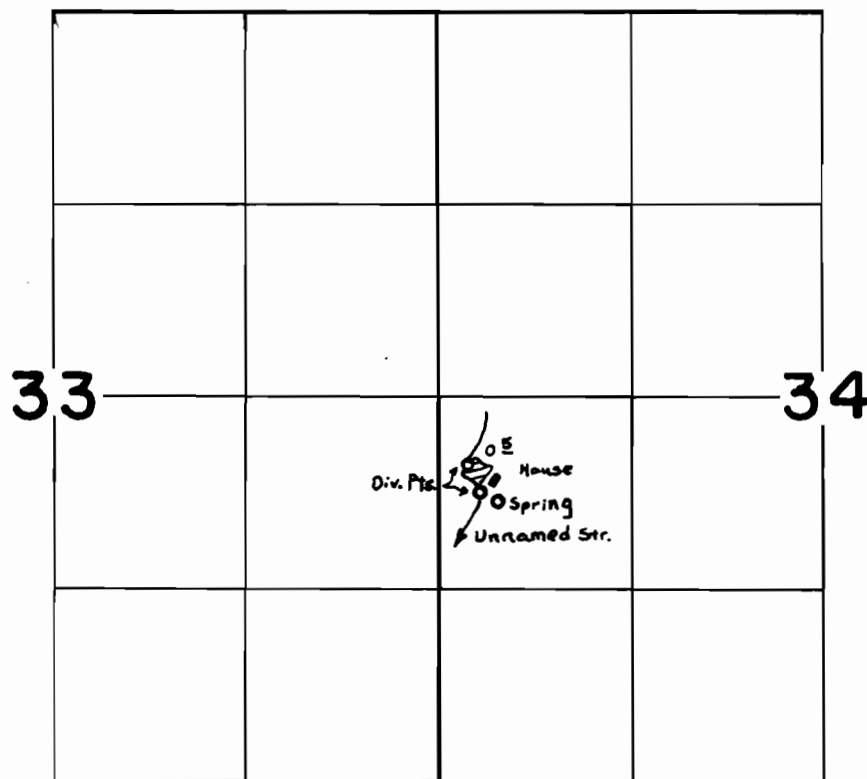

Div. Pts. Located: 470'S; 200'E; 660'S; 280'E;
Spring - 720'S; 400'E, from W $\frac{1}{4}$ cor. Sec. 34

FINAL PROOF SURVEY
UNDER

Application No. 52132 Permit No. 39265
IN NAME OF

DONALD J. & SALLY A. KUYPER

Surveyed AUG. 11 1976, by D. NORBY