


T.10S., R.2W., W.M.

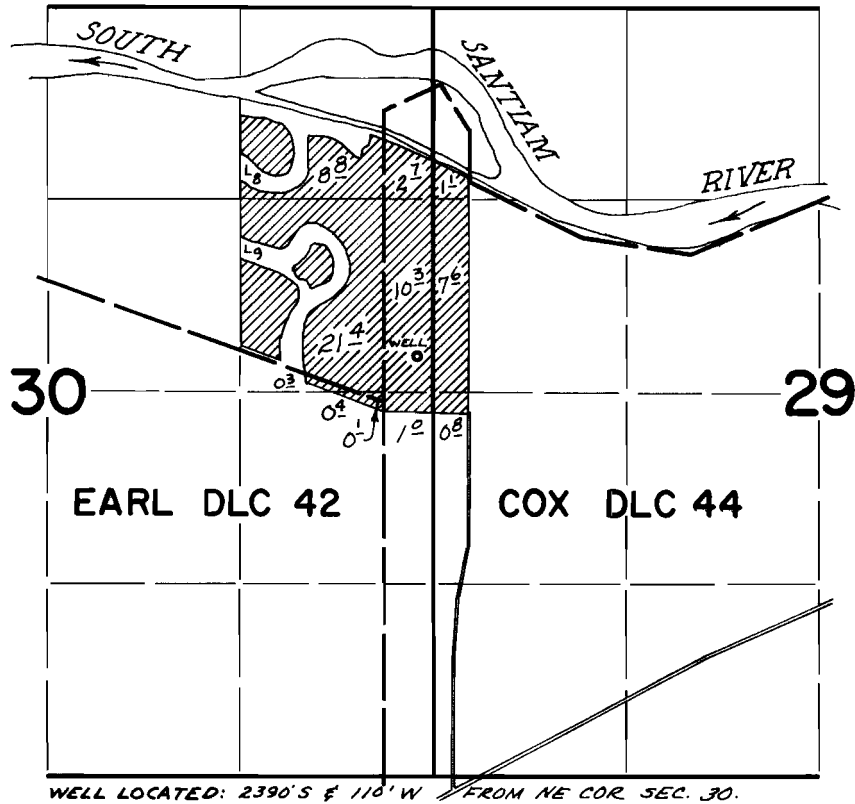

**FINAL PROOF SURVEY**  
UNDER

Application No. G-5199 Permit No. G-5067  
IN NAME OF

ROBERT N. AND ALICE M. GARRISH

Surveyed Oct. 18 1974, by D. Norby