


T.10S. R.1W. W.M.

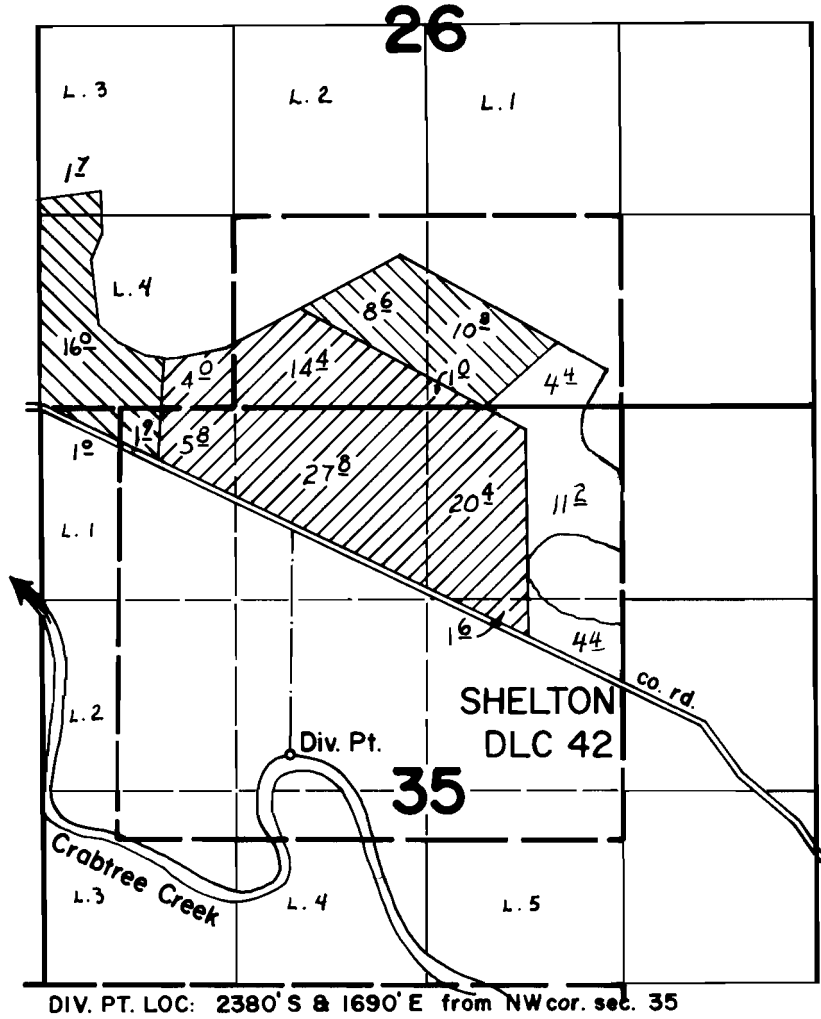

 Permit 37340
 Permit 40541

FINAL PROOF SURVEY UNDER

54155 40541
 Application No. 51789 Permit No. 37340
 IN NAME OF

.....TOM COMMONS & ELLIS HALLMON.....

Surveyed Mar 30 1976, by D. Norby.....