
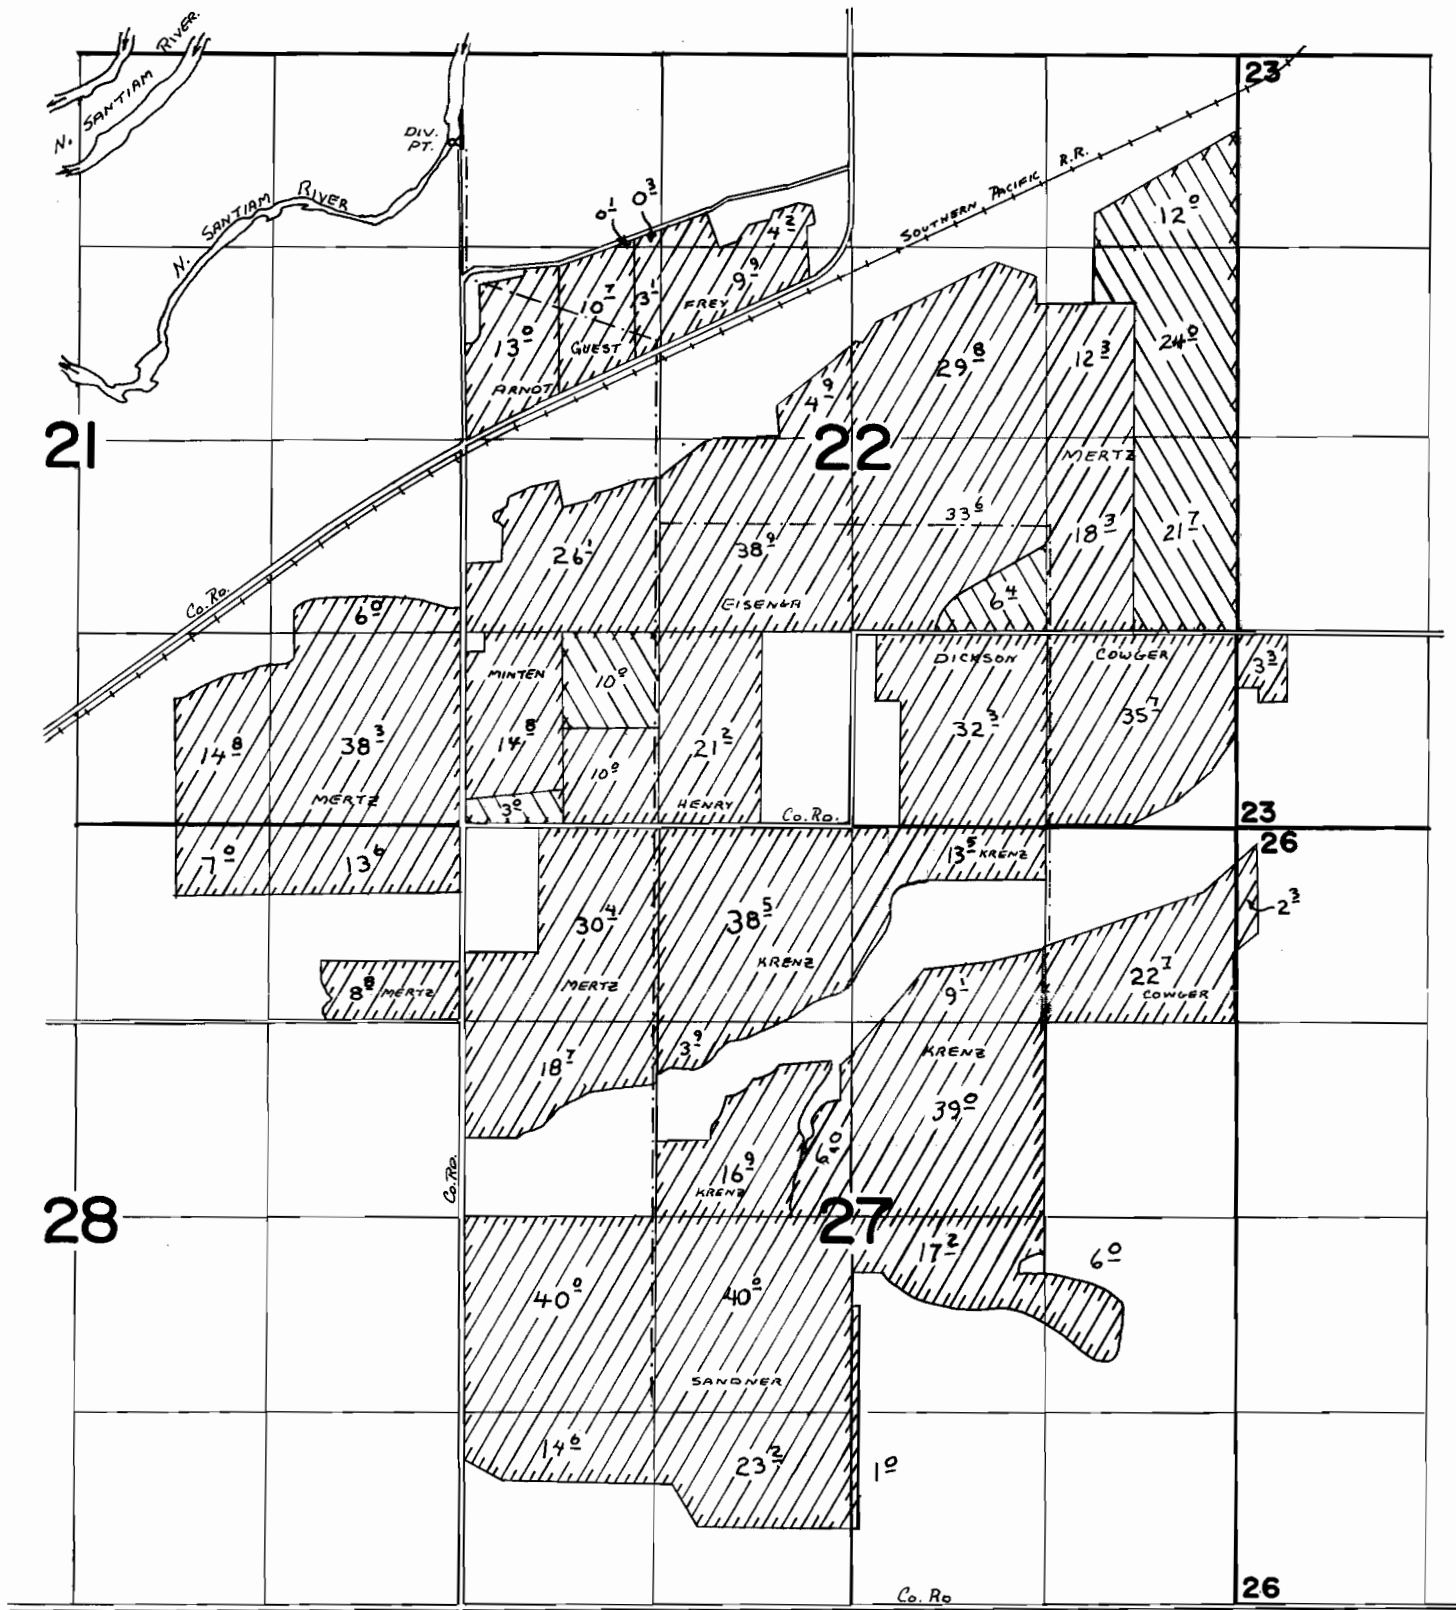



T.9S.,R.1W.,W.M.

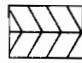

Div. Pt. Loc: 4180' N AND 100' W FROM SE COR. SEC. 21

 - APPL# 50568
 - APPL# 38109

FINAL PROOF SURVEY UNDER

Application No. 50568 Permit No. 38178
38109 28499
 IN NAME OF

QUEENER IRRIGATION IMPROVEMENT DIST.

Surveyed Aug. 12-14, 1974 by L. T. Tollett