


T.14 S. R.39 E. W.M.

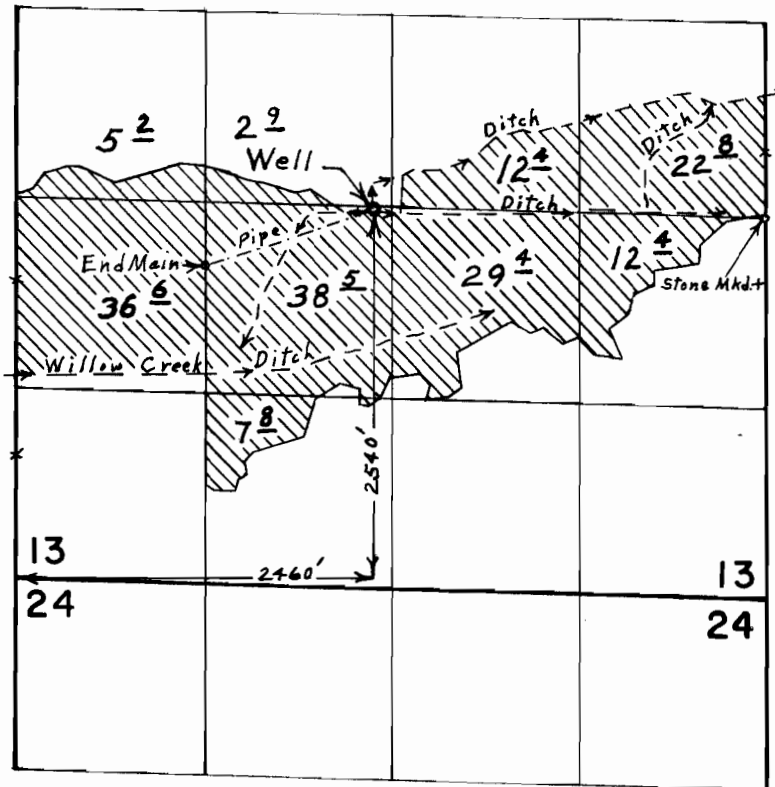

FINAL PROOF SURVEY
UNDER

Application No. G-4747 Permit No. G-4466
IN NAME OF

CARROL LOCEY & SON

Surveyed April 30, 1975, by L. E. Gould