


# T. 4 S., R. 1 W. W.M.

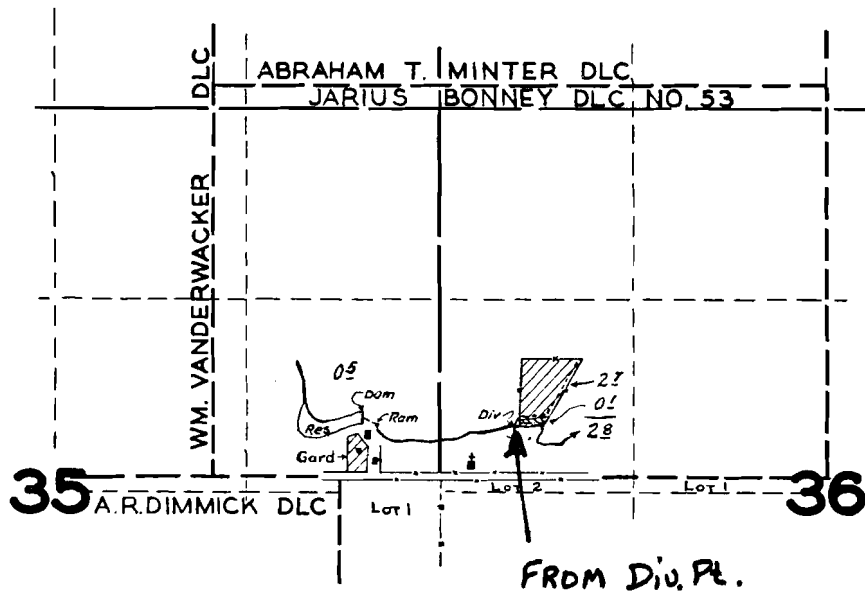

## FINAL PROOF SURVEY

UNDER

Application No. R-19438 Permit No. R-769  
19439 15037

IN NAME OF

C. C. Hepler

Surveyed June 24, 1942, by Geo. D. Paderman