


T.IN. R.I.W. W.M.

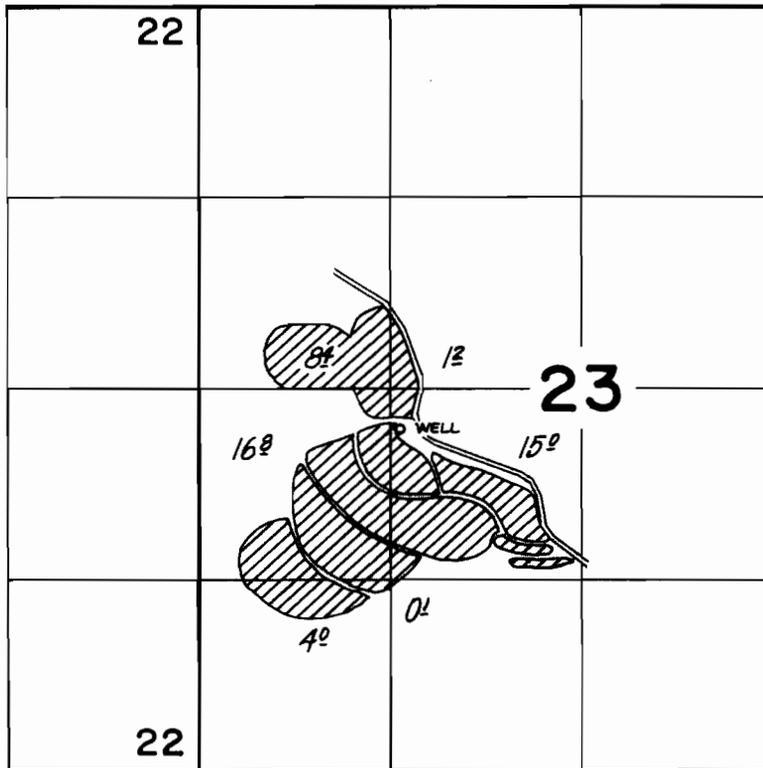

WELL LOCATED - 2360' N. & 1250' W. FROM S. 1/4 COR. SEC. 23

FINAL PROOF SURVEY UNDER

Application No. G. 3685 Permit No. G. 3354
IN NAME OF

NORTHWEST MEMORIAL GARDENS

Surveyed JULY 9 1975, by R. G. MUCKEN