


T.10S.,R.6W.,W.M.

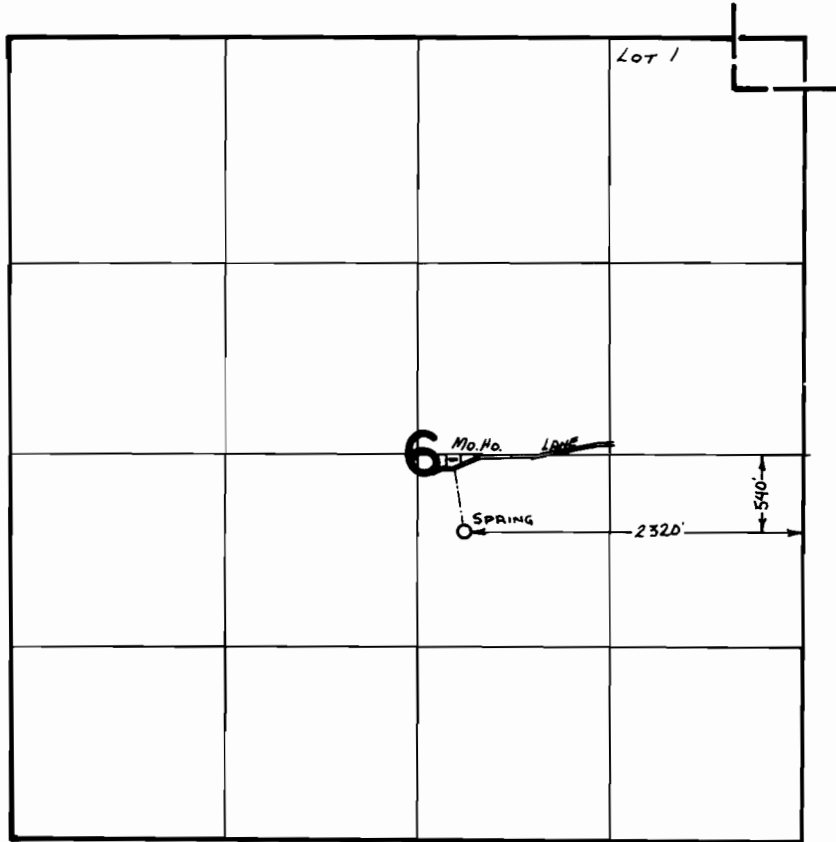

**FINAL PROOF SURVEY**  
UNDER

Application No. .47131.... Permit No. .35289.....  
IN NAME OF

.....**C. A. JOHNSTON**.....

Surveyed March.28. 1973., by ..R..MUCKEN.....