


T.3N. R.30E. W.M.

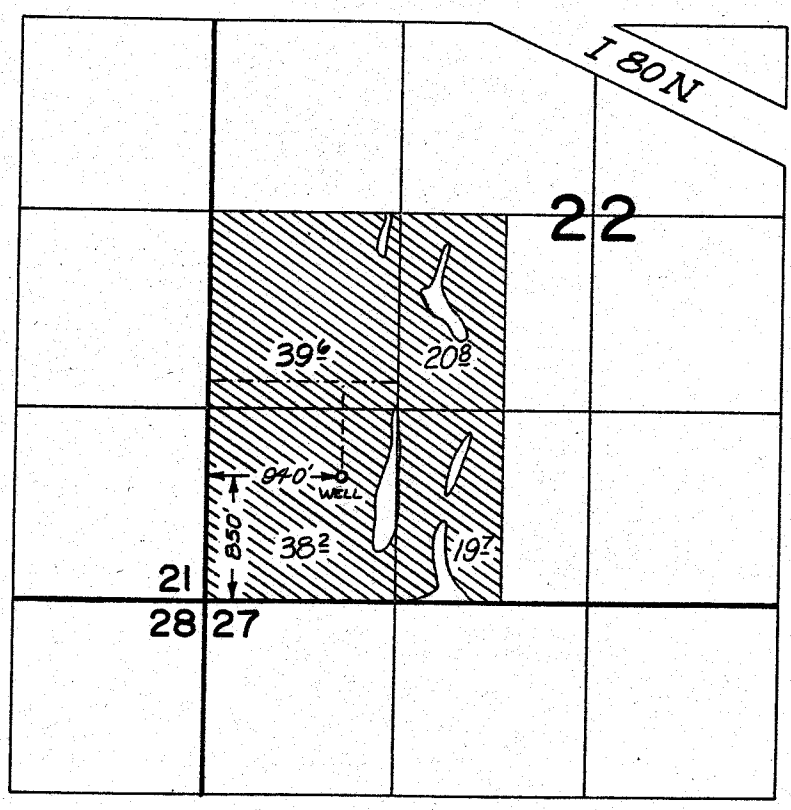

FINAL PROOF SURVEY UNDER

Application No. G 5717 Permit No. G 4955
IN NAME OF
LEON A. REESE

Surveyed APRIL 4 1975, by R. G. MUCKEN