


G 5221

74666

44778

# T. 4 N. R. 29 E. W.M.

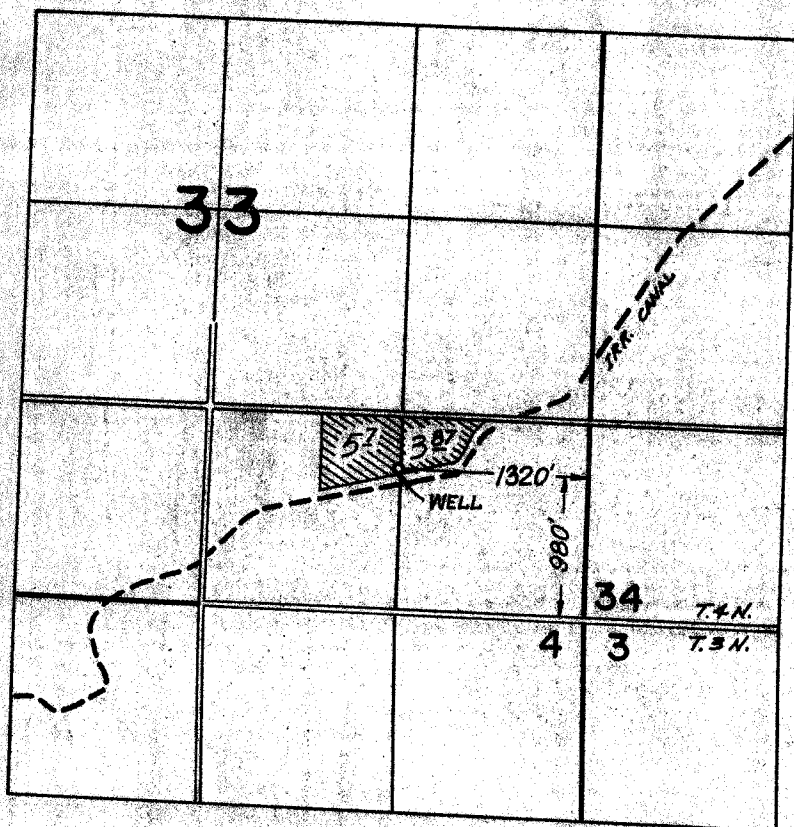

## FINAL PROOF SURVEY UNDER

Application No. 66216 Permit No. 65221  
IN NAME OF

AUSTIN A. ALFORD

Surveyed March 31 1975 by R.G. MUCKEN