


T.18S., R.1W., W.M.

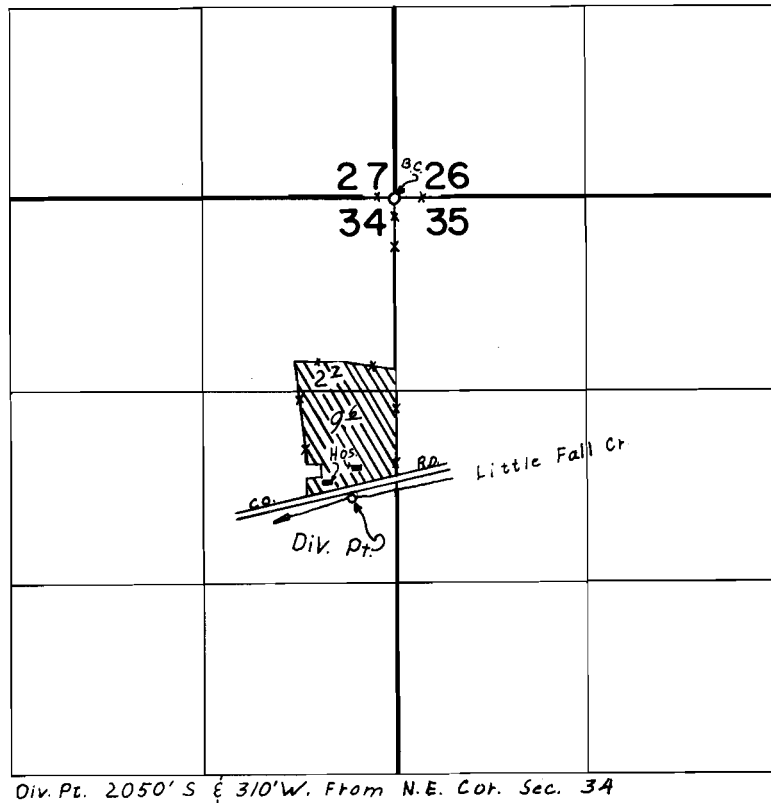

Div. Pt. 2050' S & 310' W. From N.E. Cor. Sec. 34

FINAL PROOF SURVEY
UNDER

Application No. 43875 Permit No. 32785
IN NAME OF

RAY FITZGERALD

Surveyed April 23, 1975, by R. MUCKEN