


T.23S., R.32 1/2 E., W.M.

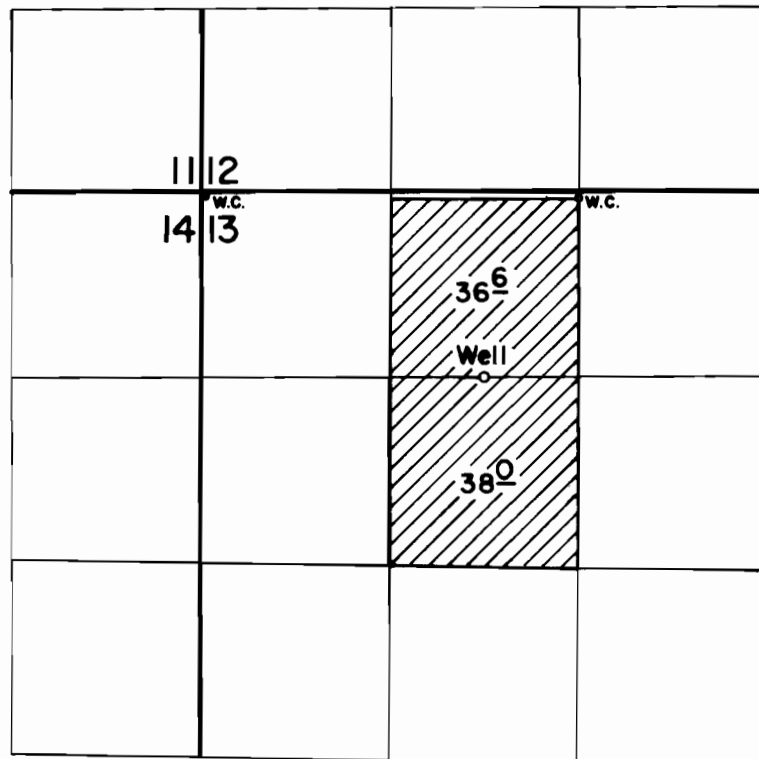

WELL LOC: 1270' S & 640' W FROM N 1/4 COR. SEC. 13

FINAL PROOF SURVEY
UNDER

Application No. G-5951 Permit No. G-5649
IN NAME OF

ED V. SIMPSON

Surveyed April 24 1976, by D. Norby