T.2 N. R.13E. W.M.

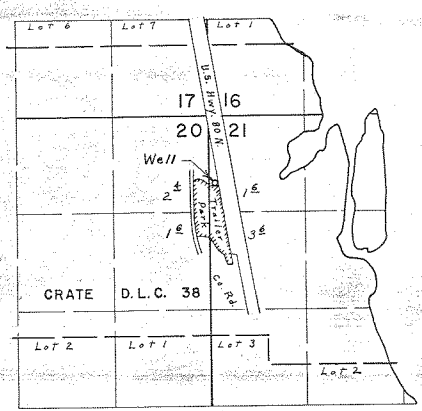

Well located 920'S. & 80'E. from N.W. Cor. Sec. 21

FINAL PROOF SURVEY
UNDER

Application No. G-5025 Permit No. G-4732
IN NAME OF
MOBILE ASSOCIATES, INC.

Surveyed April 25, 1974, by David Norby

A21 41065 572-37 LEG