


T.1N. R.3W. W. M.

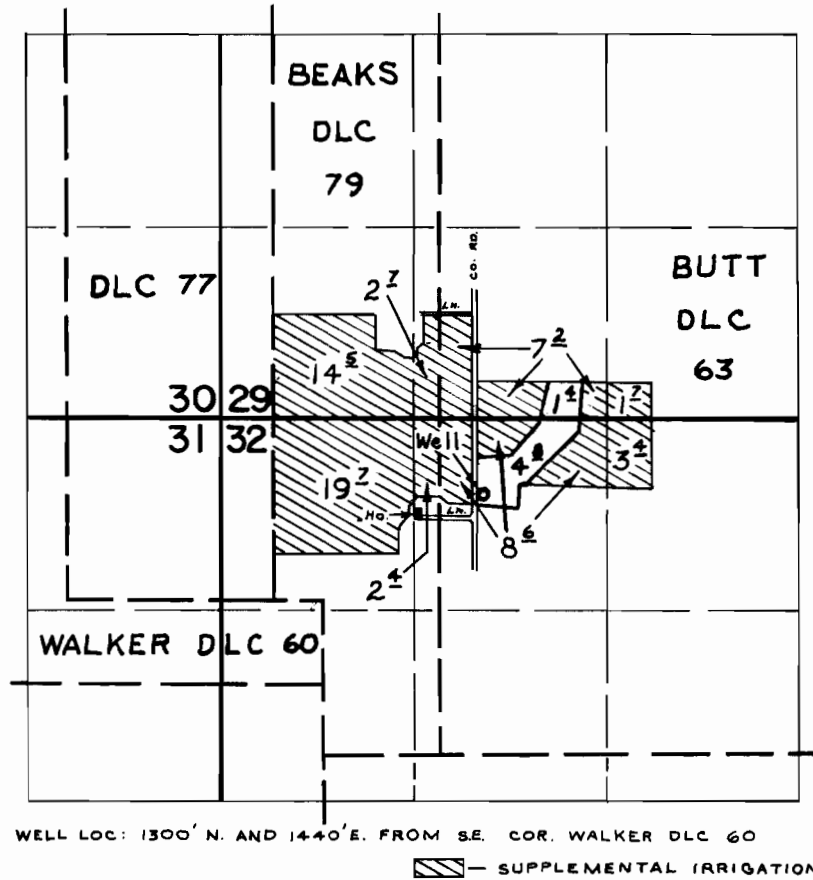

FINAL PROOF SURVEY UNDER

Application No. G-4055 Permit No. G-3803
IN NAME OF

EDWARD C. & DOROTHY PORTER

Surveyed August 8, 1975, by R. Mucken