


T.1S. R.2W. W.M.

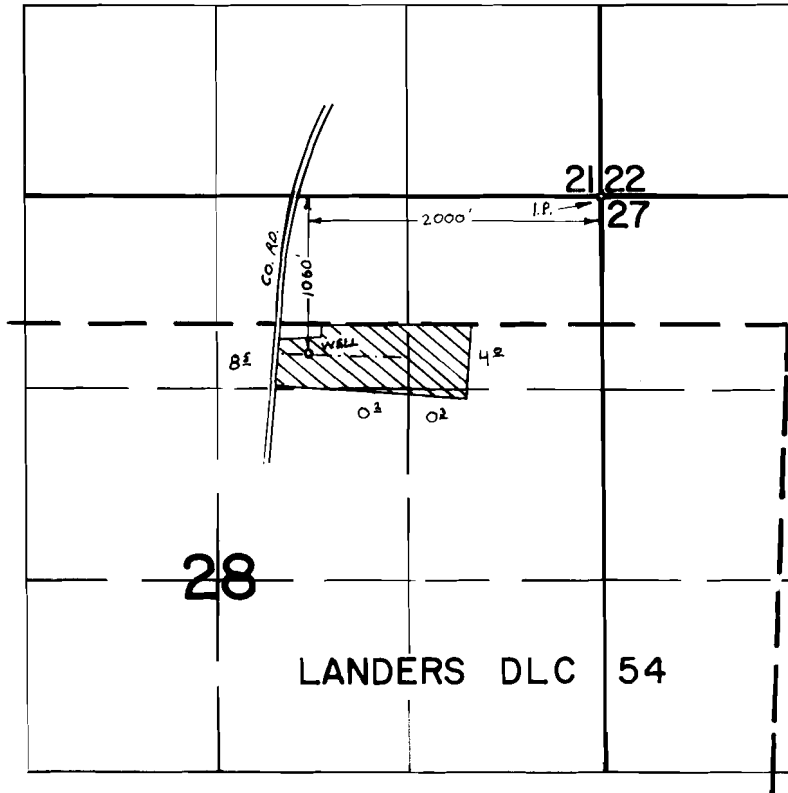

FINAL PROOF SURVEY
UNDER

Application No. G-5203 Permit No. G-5024
IN NAME OF

CHARLES L. or KATHERINE L. STARR

Surveyed June 21, 1974, by R. Mucken