


T.1N. R.3W. W. M.

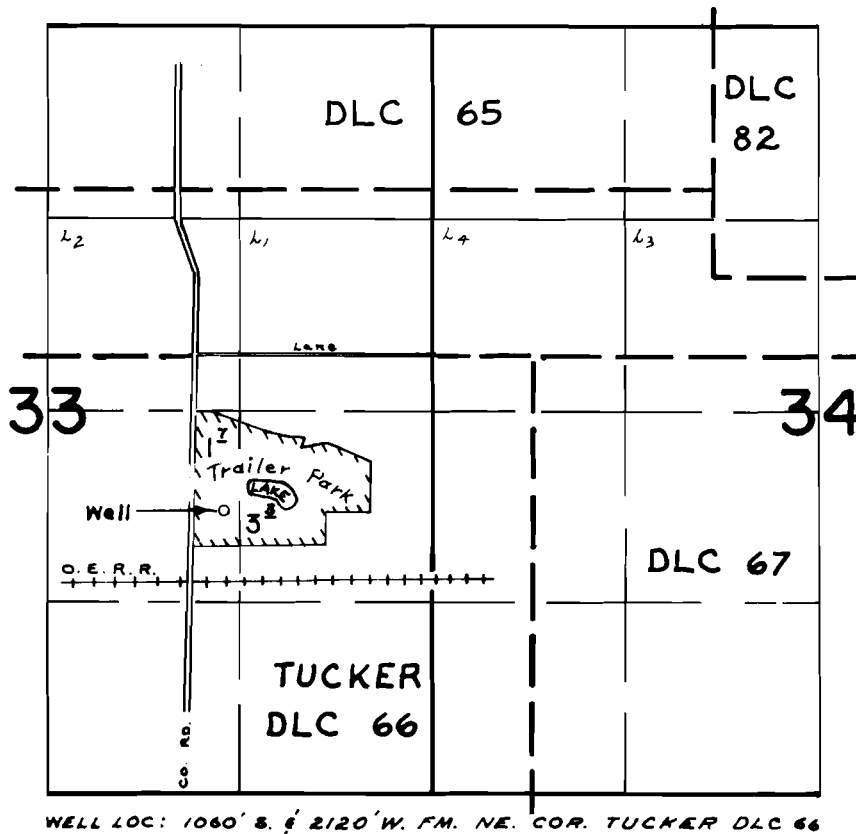

WELL LOC: 1060' S. & 2120' W. FM. NE. COR. TUCKER DLC 66

**FINAL PROOF SURVEY**  
· UNDER

Application No. G-5196 Permit No. G-5064  
IN NAME OF

FOREST HILLS MOBILE VILLAGE

Surveyed Aug. 8, 1975, by R. Mucken