


T. I. S., R. I. W., W. M.

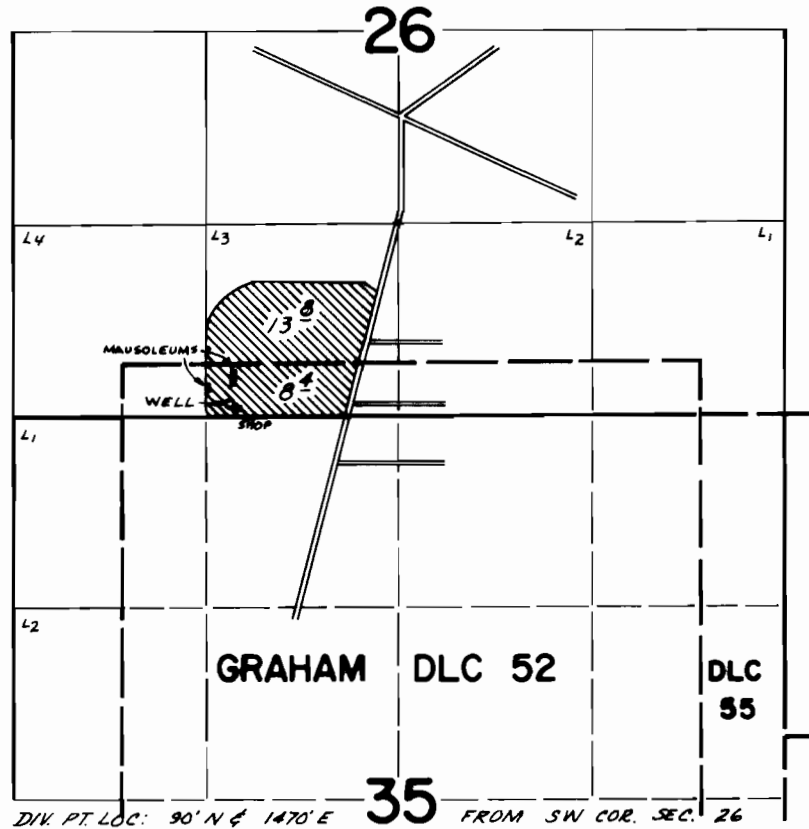

FINAL PROOF SURVEY UNDER

Application No. G-5938 Permit No. G-5154
IN NAME OF

CRESCENT GROVE CEMETERY AND MAUSOLEUM ASSOCIATION

Surveyed May 13 1975, by R. G. Mucken