


T.2S. R.1W.W.M.

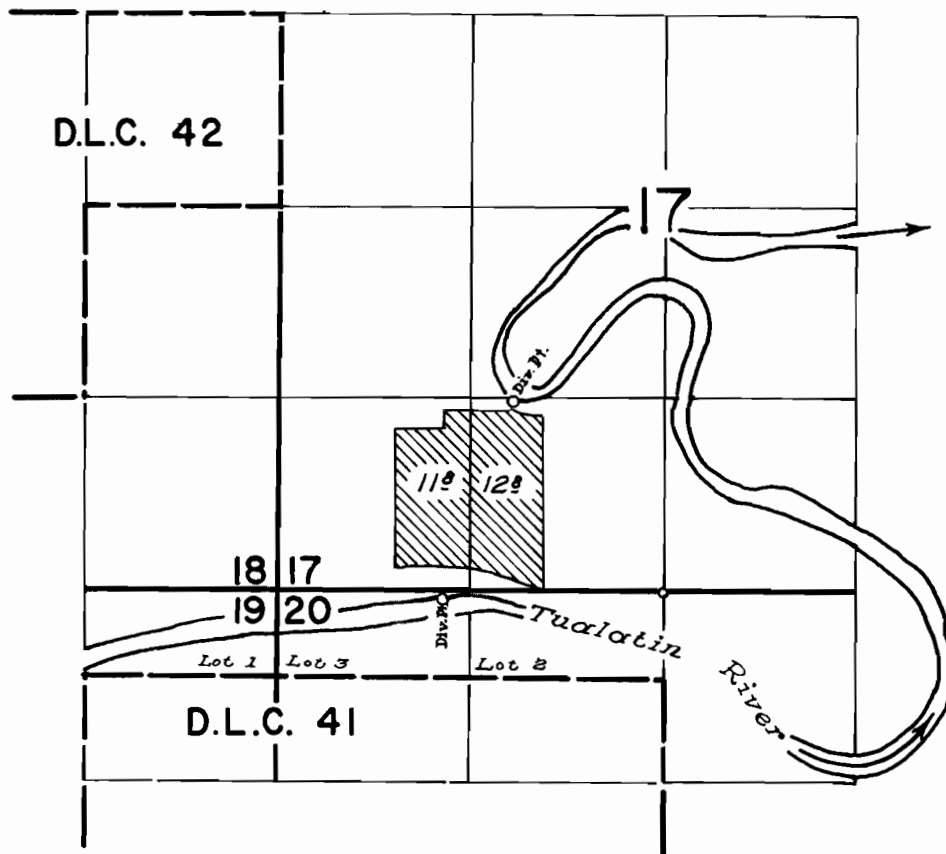

FINAL PROOF SURVEY UNDER

Application No. 30869 Permit No. 24369
IN NAME OF

STEINHOFF HEIRS

Surveyed May 23 1960, by

[Handwritten signature]