


T.2N. R.4W. W. M.

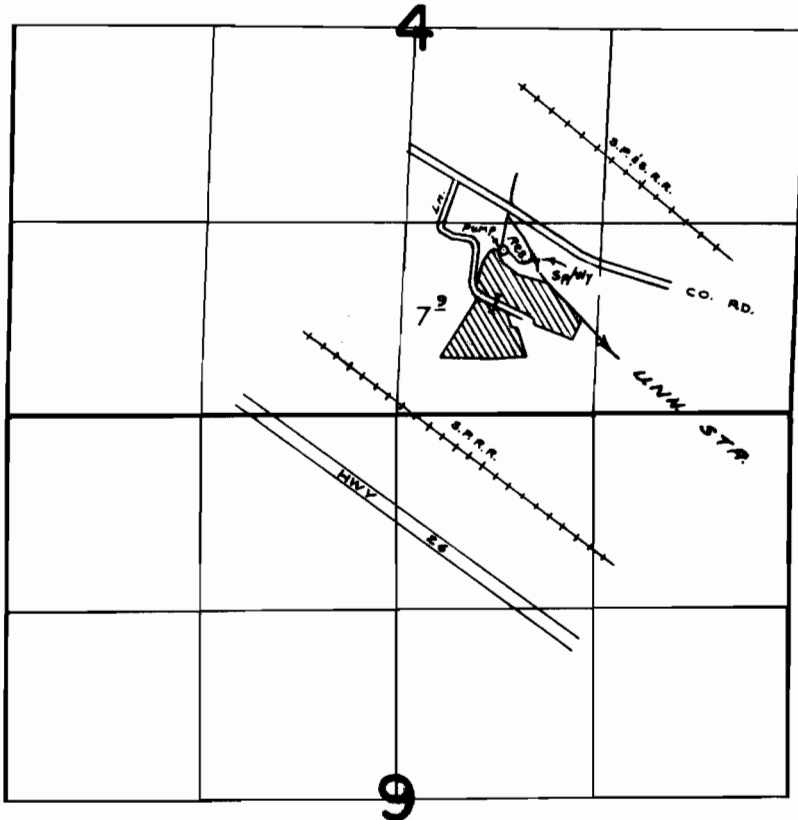

DAM LOCATED: 1130' N. and 710' E. From S. 1/4 CORNER SECTION 4

FINAL PROOF SURVEY
UNDER

R-44497 R-5407
Application No. 44498 Permit No. 34067
IN NAME OF

LOYD MORGAN

Surveyed Sept. 12, 1975, by R. Mucken