


T.1S. R.3W. W.M.

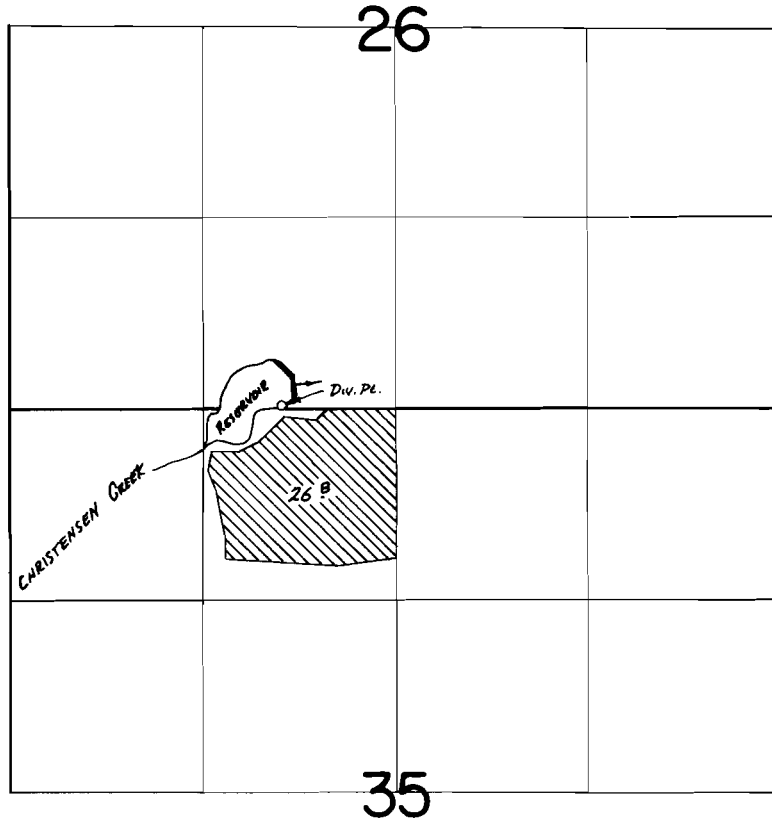

DIV. PT. 10C. 10' N & 790' W FROM N 1/4 COR. SEC. 35

**FINAL PROOF SURVEY**  
UNDER

Application No. 45989... Permit No. 34350...  
IN NAME OF

ALVIN JOHN HAASE

Surveyed July 25 1974, by R. G. MUCKEN