


T. 2 S. R. 3 W. W.M.

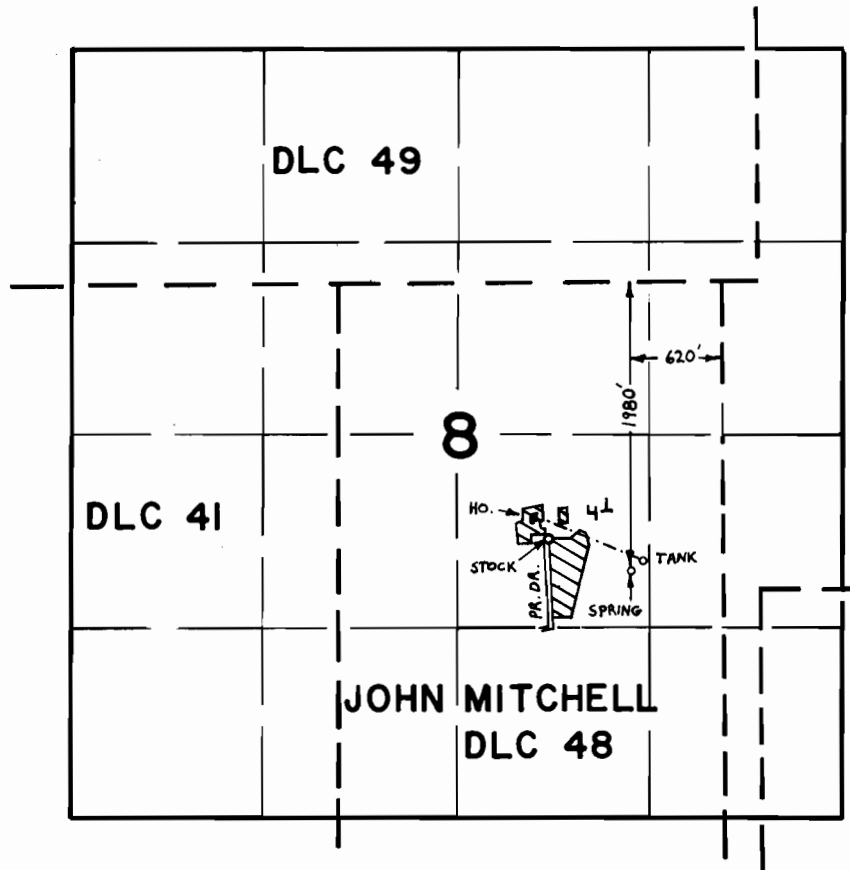

**FINAL PROOF SURVEY**  
UNDER

Application No. 47076 Permit No. 35207  
IN NAME OF

EMORY L. PERSON

Surveyed JULY 3, 1975, by R. MUCKEN