


T.2S. R.2W. W. M.

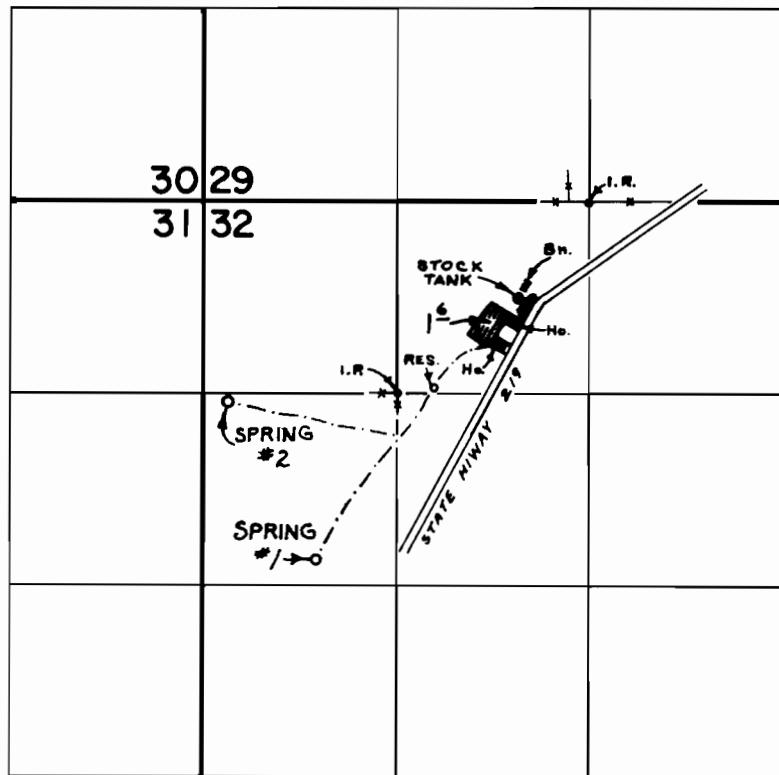

SPRINGS LOC: NO. 1 - 2460' S. & 1860' W., NO. 2 - 1370' S. & 2470' W.
BOTH FM. N. 1/4 COR. SEC. 32

FINAL PROOF SURVEY
UNDER

Application No. 47174 Permit No. 35347
IN NAME OF

WILLIAM C. & ILENE V. ROGERS

Surveyed May 15, 1975, by R. Mucken