


T.2N., R.2W., W.M.

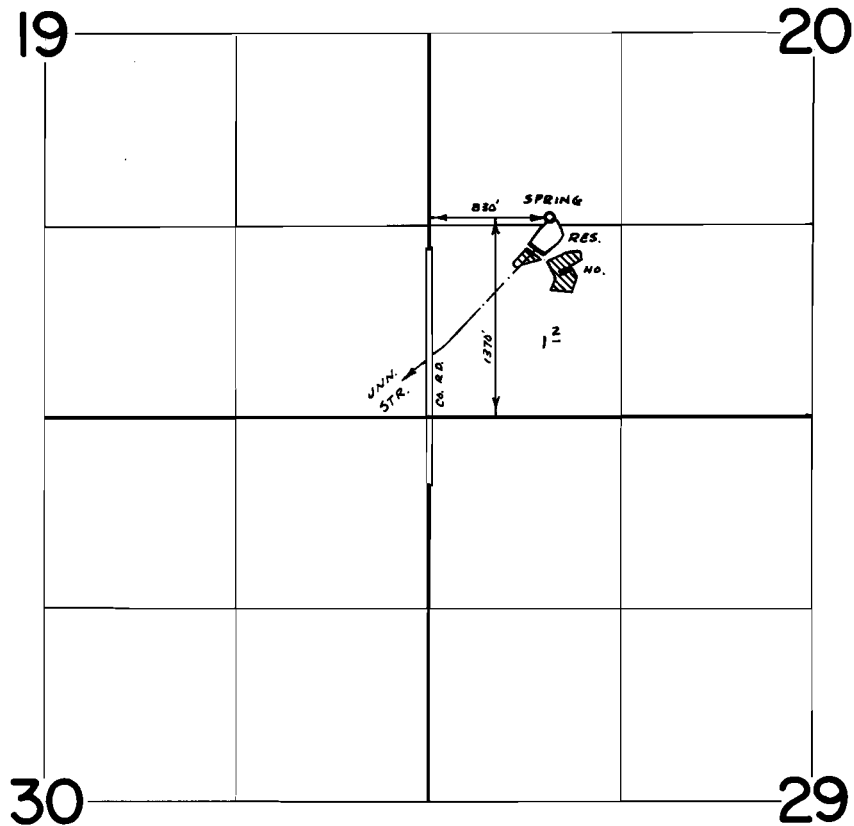

FINAL PROOF SURVEY
UNDER

Application No. **R-47661** **47501** Permit No. **R-5728** **35578**
IN NAME OF

BERNARD S. DOUGLASS

Surveyed **Sept. 10** **1975**, by **R.G. Mucken**