


T.2N., R.2W., W.M.

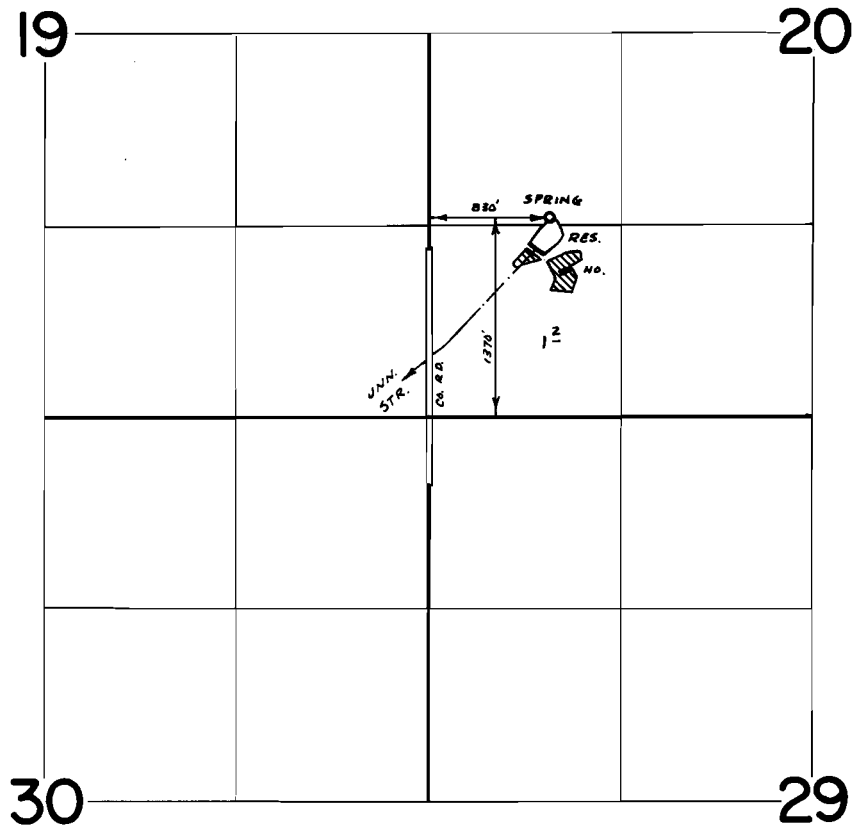

FINAL PROOF SURVEY
UNDER

Application No. R-47661 47501 Permit No. R-5728 35578
IN NAME OF

BERNARD S. DOUGLASS

Surveyed Sept. 10 1975, by R.G. Mucken