


T.2N. R.4W. W. M.

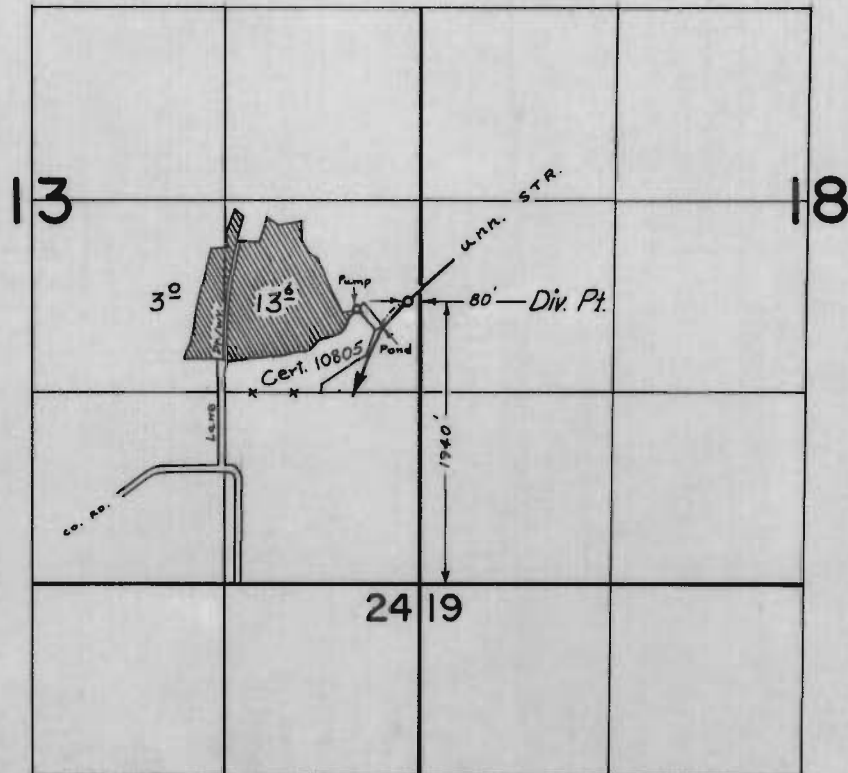

FINAL PROOF SURVEY
UNDER

Application No. 47856 Permit No. 35866
IN NAME OF

LEONARD & ALFREDA ENDRESEN

Surveyed Sept. 8, 1975, by R. Mucken