


T.3&4 S. R.5 W. W.M.

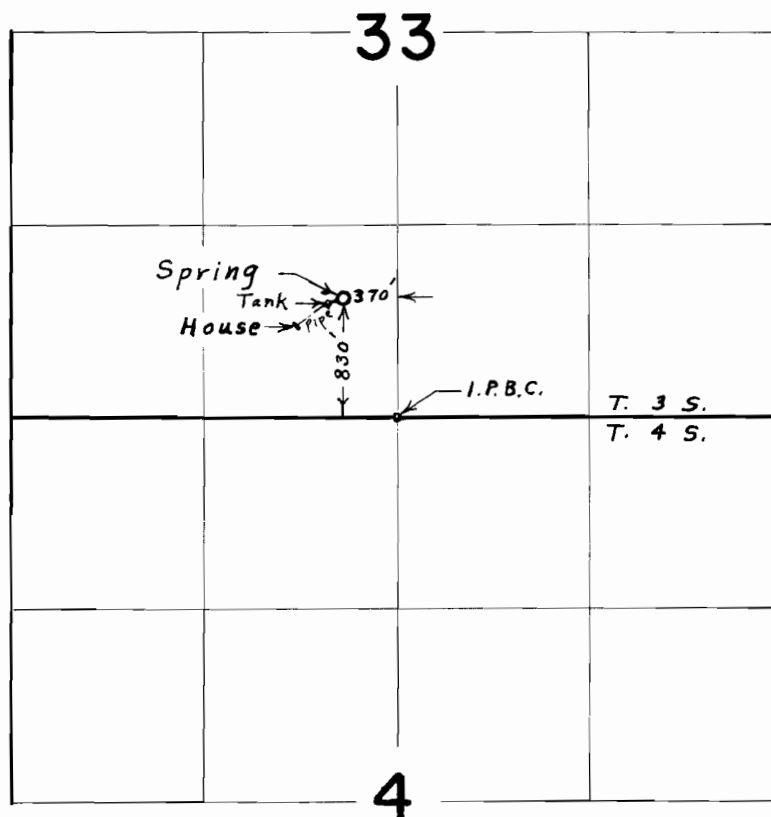

FINAL PROOF SURVEY
UNDER

Application No. 47466 Permit No. 35556
IN NAME OF

MR. & MRS. GENE SALSGIVER

Surveyed April 18, 1975, by L. E. Gould