


# T. 2 S. R. 3 W. W.M.

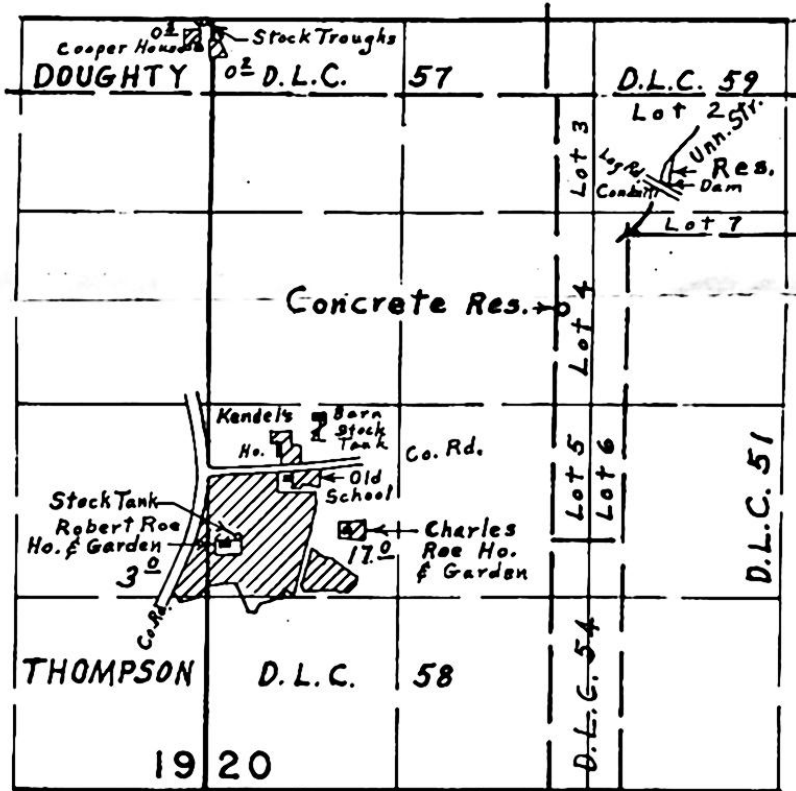

Div. Pt. located 600' S. & 720' E. from N.E. Cor. Thompson D.L.C. 58

## FINAL PROOF SURVEY

UNDER

Application No. 48628 Permit No. R-5878 36301

IN NAME OF

ROBERT B. ROE

Surveyed July 31, 1975, by L. E. Gould