


T.6N., R.2W., W.M.

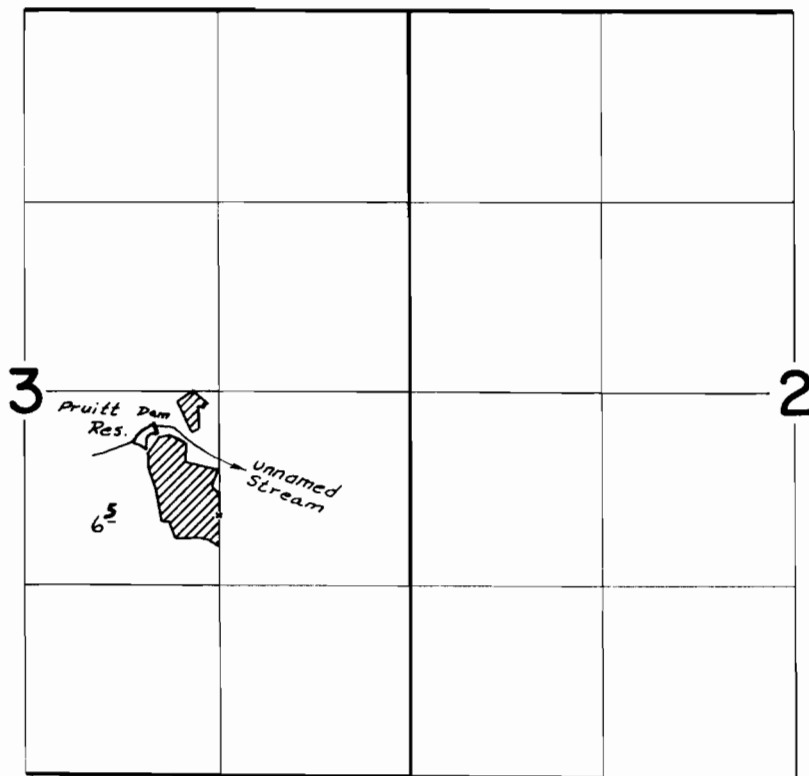

RES. LOC: 2390' N & 1750' W FROM SE COR. SEC. 3

FINAL PROOF SURVEY
UNDER

Application No. 45003 Permit No. 33534
R-45102 R-5296
IN NAME OF

HARVEY A. SPENCE

Surveyed Sept. 30 1975, by D. Norby