


T. 4 N. R. 2 W. W.M.

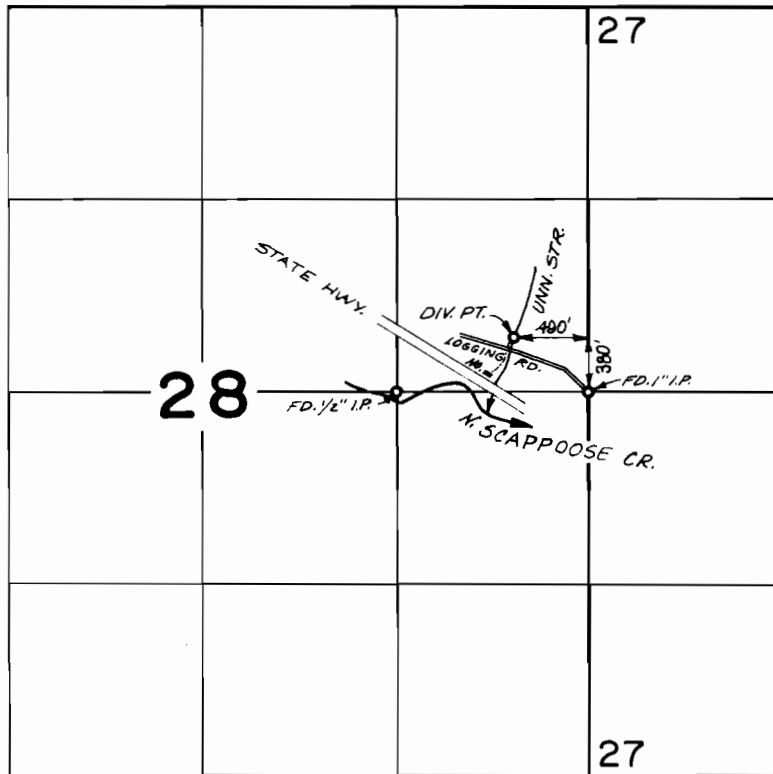

FINAL PROOF SURVEY
UNDER

Application No. 47208 Permit No. 35361
IN NAME OF

EVA MAGWOOD & ROBERT ROBINSON

Surveyed JUNE 10 1975, by R.G. MUCKEN