T. 4 N. R. 2 W. W.M.

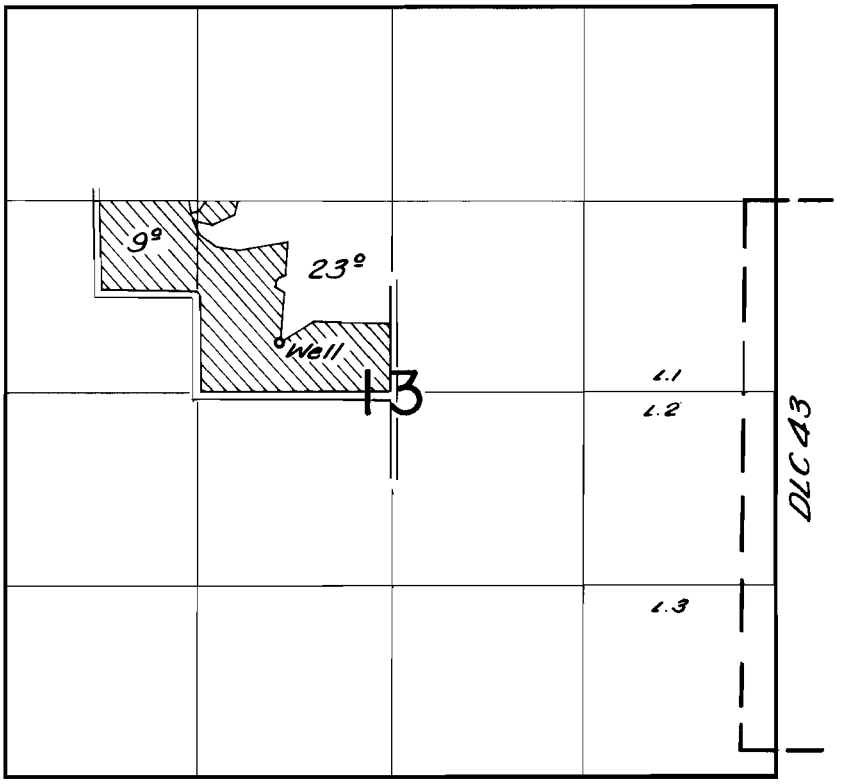

FINAL PROOF SURVEY
UNDER

Application No. G-1565 Permit No. G-1447
IN NAME OF

PAUL J. DE SHAZER

Surveyed July 19 1960, by C. O. Bartels

1960-X