


T.40S. R.13W. W.M.

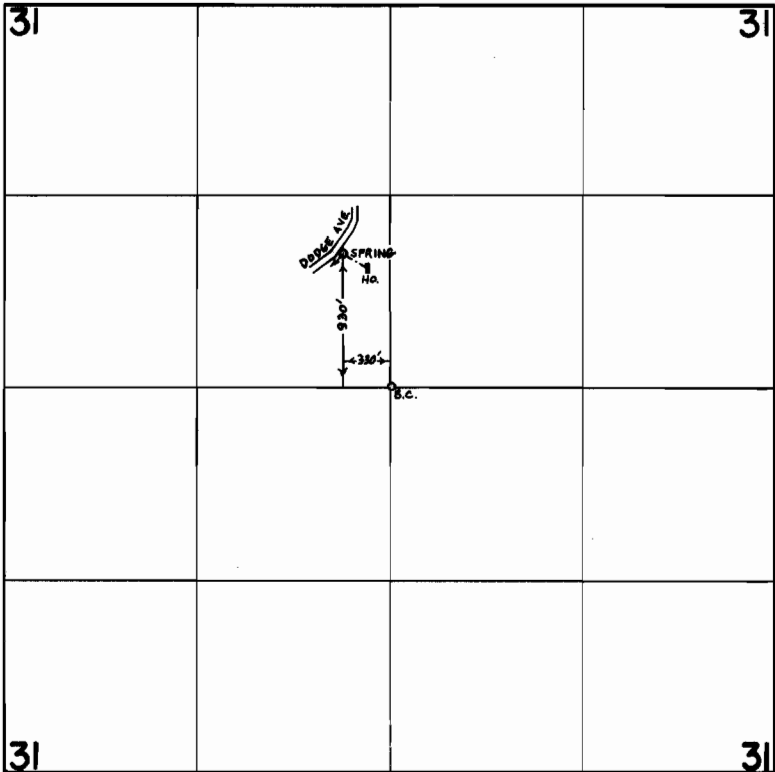

FINAL PROOF SURVEY
UNDER

Application No. 48529 Permit No. 36365
IN NAME OF

NEWTON E. & XONDRA K. TUBBS

Surveyed JULY 24 1975, by L. TOLL