


T.40S. R.14W. W.M.

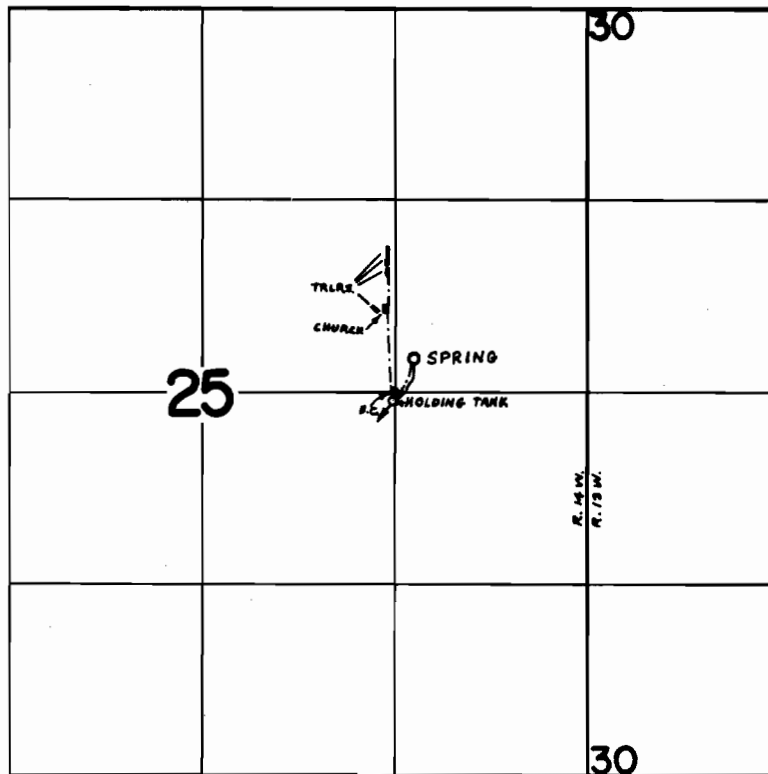

SPRING LOC.: 230' N. 130' E. FROM SE COR SW 1/4 NE 1/4 SEC. 25

FINAL PROOF SURVEY
UNDER

Application No. 48903 Permit No. 36632
IN NAME OF

CHARLES E. & CAROL E. INGLIS

Surveyed JULY 23, 1975, by L. TOLL