


T. 38 S. R. 14 W. W.M.

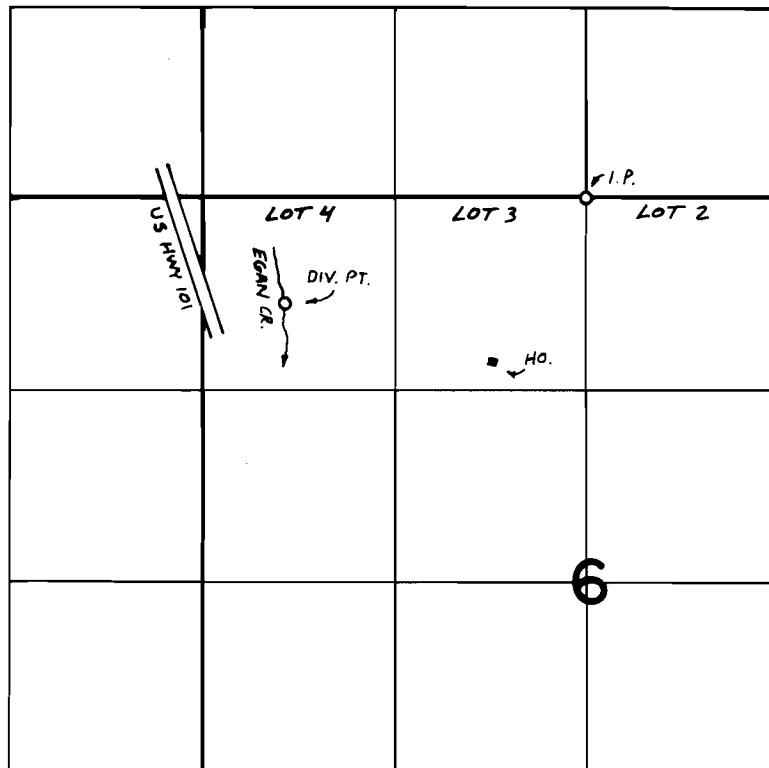

DIVERSION POINT LOCATED 730'S & 2080' W FROM THE NE COR.
LOT 3

FINAL PROOF SURVEY
UNDER

Application No. 49703 Permit No. 37127
IN NAME OF

DAVID S. SCHREIBER

Surveyed OCT. 27. 1976., by L. E. GOULD