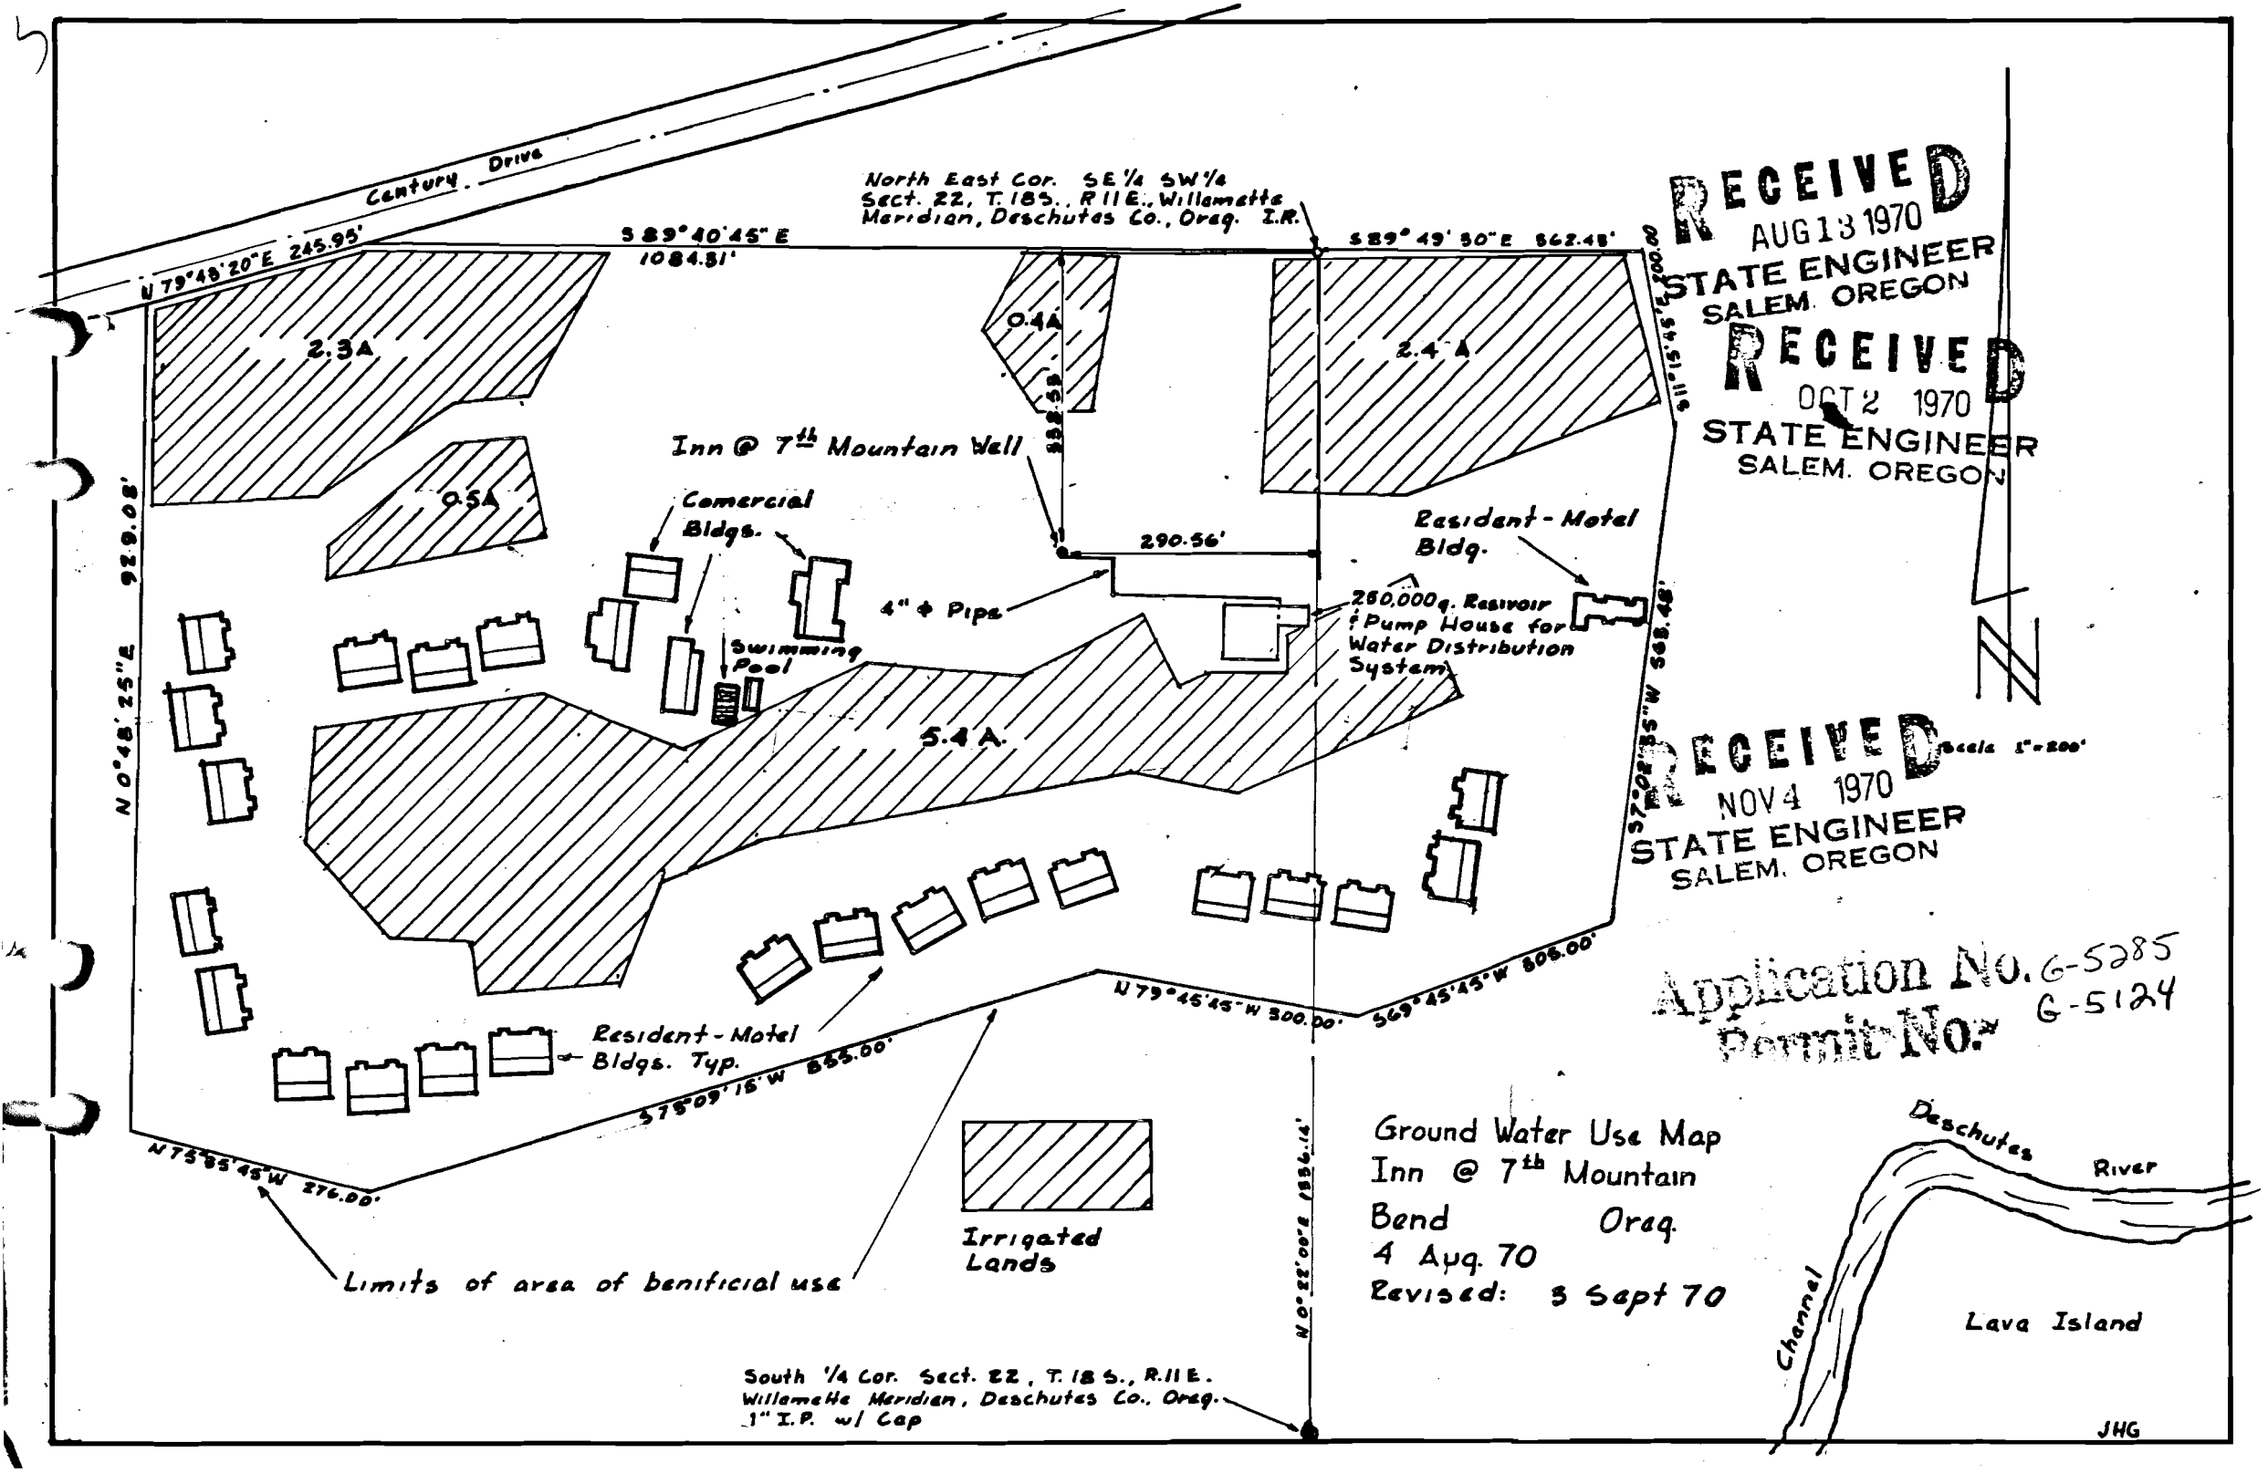
Century Drive
N 79°48'20"E 245.95'
S 89°40'45" E
1084.81'
North East Cor. SE 1/4 SW 1/4
Sect. 22, T. 18S., R 11E., Willamette
Meridian, Deschutes Co., Oreg. I.R.
S 89° 49' 50" E 862.48'
2.3A
0.4A
2.4 A
0.5A
Inn @ 7th Mountain Well
Comercial Bldgs.
290.56'
Resident - Motel Bldg.
4" ϕ Pipe
280,000 g. Resivoir & Pump House for Water Distribution System
Swimming Pool
5.4 A.
N 0°48'25"E 929.08'
S 7°02'35"W 568.48'
Scale 1"=200'
N 79°45'45"W 300.00'
S 69°45'45"W 806.00'
Resident - Motel Bldgs. Typ.
S 75°09'15"W 855.00'
N 75°55'45"W 276.00'
Limits of area of benificial use
Irrigated Lands
N 0°22'00"E 1886.14'
South 1/4 Cor. Sect. 22, T. 18 S., R. 11 E.
Willamette Meridian, Deschutes Co., Oreg.
1" I.P. w/ Cap
Ground Water Use Map
Inn @ 7th Mountain
Bend Oreg.
4 Aug. 70
Revised: 3 Sept 70
Deschutes River
Channel
Lava Island
JHG
RECEIVED
AUG 13 1970
STATE ENGINEER
SALEM, OREGON
RECEIVED
OCT 2 1970
STATE ENGINEER
SALEM, OREGON
RECEIVED
NOV 4 1970
STATE ENGINEER
SALEM, OREGON
Application No. G-5285
Permit No. G-5124