


# T.32S. R.4W. W.M.

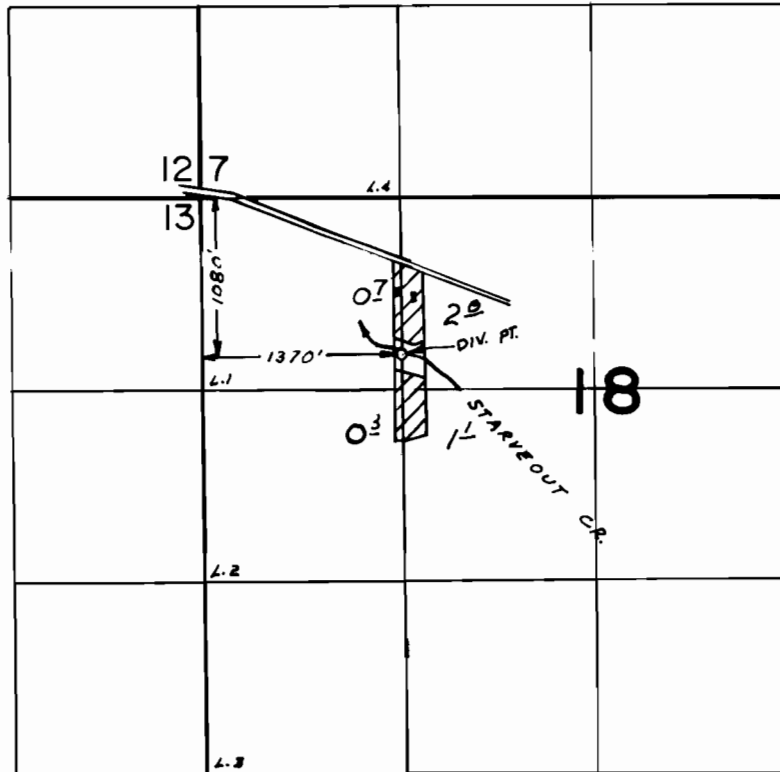

## FINAL PROOF SURVEY UNDER

Application No. 45152..... Permit No. 33734  
IN NAME OF

..... RONALD R. & CONNIE M. EHLI .....

Surveyed JUL. 14. 1976, by L.H. NUNN .....