


T.29S. R.7W.W.M.

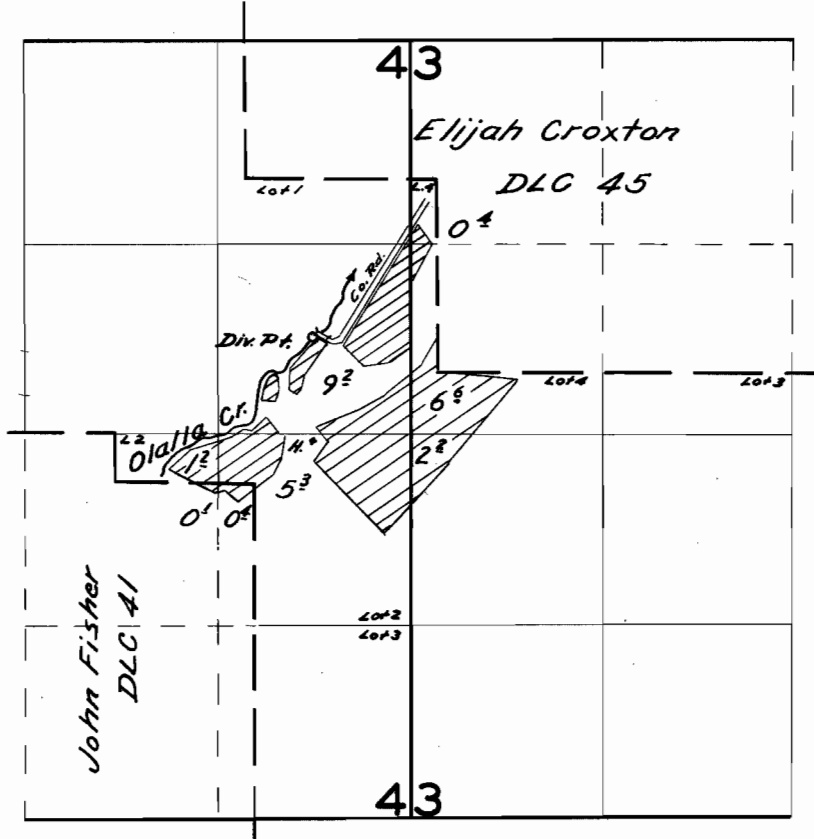

FINAL PROOF SURVEY

UNDER

Application No. 25332 Permit No. 19875
IN NAME OF

Douglas W. & Charlotte Parazoo

Surveyed Aug. 26 1956, by C.O. Bartels