


T.14S.,R.32E.,W.M.

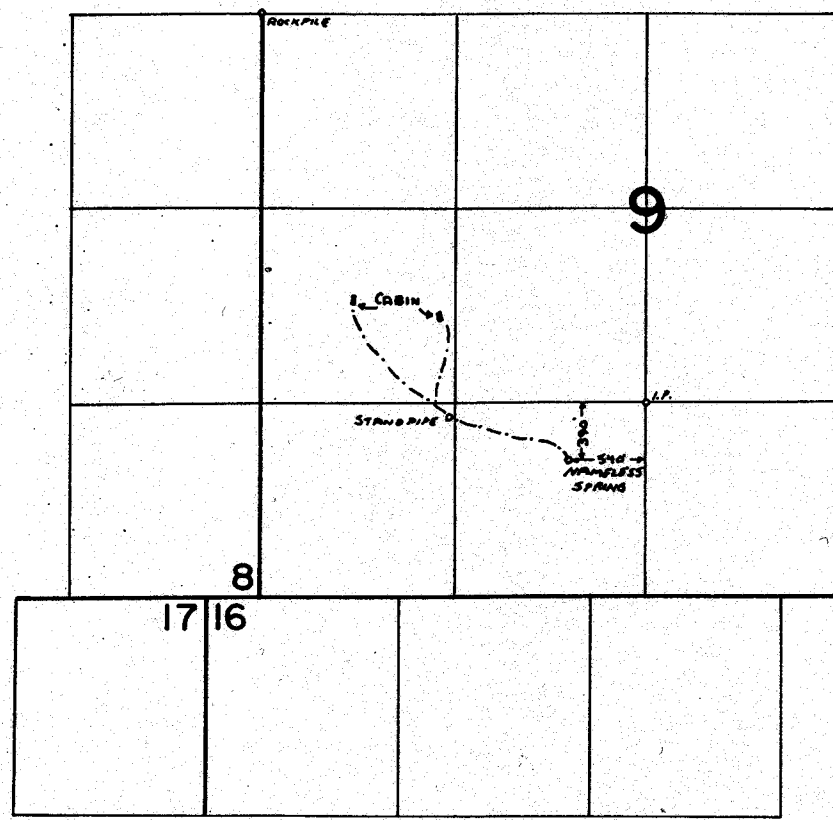

FINAL PROOF SURVEY
UNDER

Application No. 47417 Permit No. 35532
IN NAME OF
CARL SHEEDY
Surveyed Aug. 28. 1975, by L. Tall